

CERTIFIED LAND CORNER RESTORATION

State of Wisconsin }
 County of Forest } ss.

I William B. Cochran, do hereby certify that on the 24th day of March, 19 88, I found evidence of the Southwest Section corner of Section 16 Township 39, North, Range 13 East, Fourth Principal Meridian, as described hereon; and that from this evidence I established a new monument and accessories as described hereon to perpetuate the original location of this corner.

Resident witnesses:

History of original corner establishment:

Original survey in 1865 by William E. Daugherty.
 80 chains North between sections 20 and 21 set post. From which:

W. Pine	30"	N25°W	521ks
W. Pine	30"	S31°E	101ks

In 1929 Melindy found evidence of the original corner and made new bearing trees;

W. Pine	30"	N19°E	23'
W. Pine	30"	S56°W	44'

Description of corner evidence found:

Found remains of wood post in post hole, large rotted W. Pine stumps:

W. Pine	30"	N25°W	34'
W. Pine	30"	S31°E	6.60'
W. Pine	30"	N19°E	23.00'
W. Pine	30"	S56°W	44.00'

Description of monument and accessories I established to perpetuate the original location of this corner.

At the found original corner position. Set a 2½"X36" aluminum pipe monument 2½ feet in the ground with an aluminum cap stamped: T39N, R13E, S17, S16, S20, S21, 1988, S-1107. From which:


Maple	11"	N13°E	20.66'
Maple	12"	S46°E	14.85'
Maple	12"	S47°W	16.99'
Maple	10"	N37°W	20.98'
Steel sign post		West	.75'

Dated at Hiles, Wis., this 12 day of December, 19 94

Signature William B. Cochran Title Land Surveyor Registration No. S-1107
 (County Surveyor, Registered Land Surveyor, or other duly authorized official)

Office of Register of Deeds, County of Forest, I hereby certify that the within instrument was filed in this office for record on the 23rd day of August, 19 96 at 2:30 o'clock P M.

By [Signature] Deputy
 (Register of Deeds)

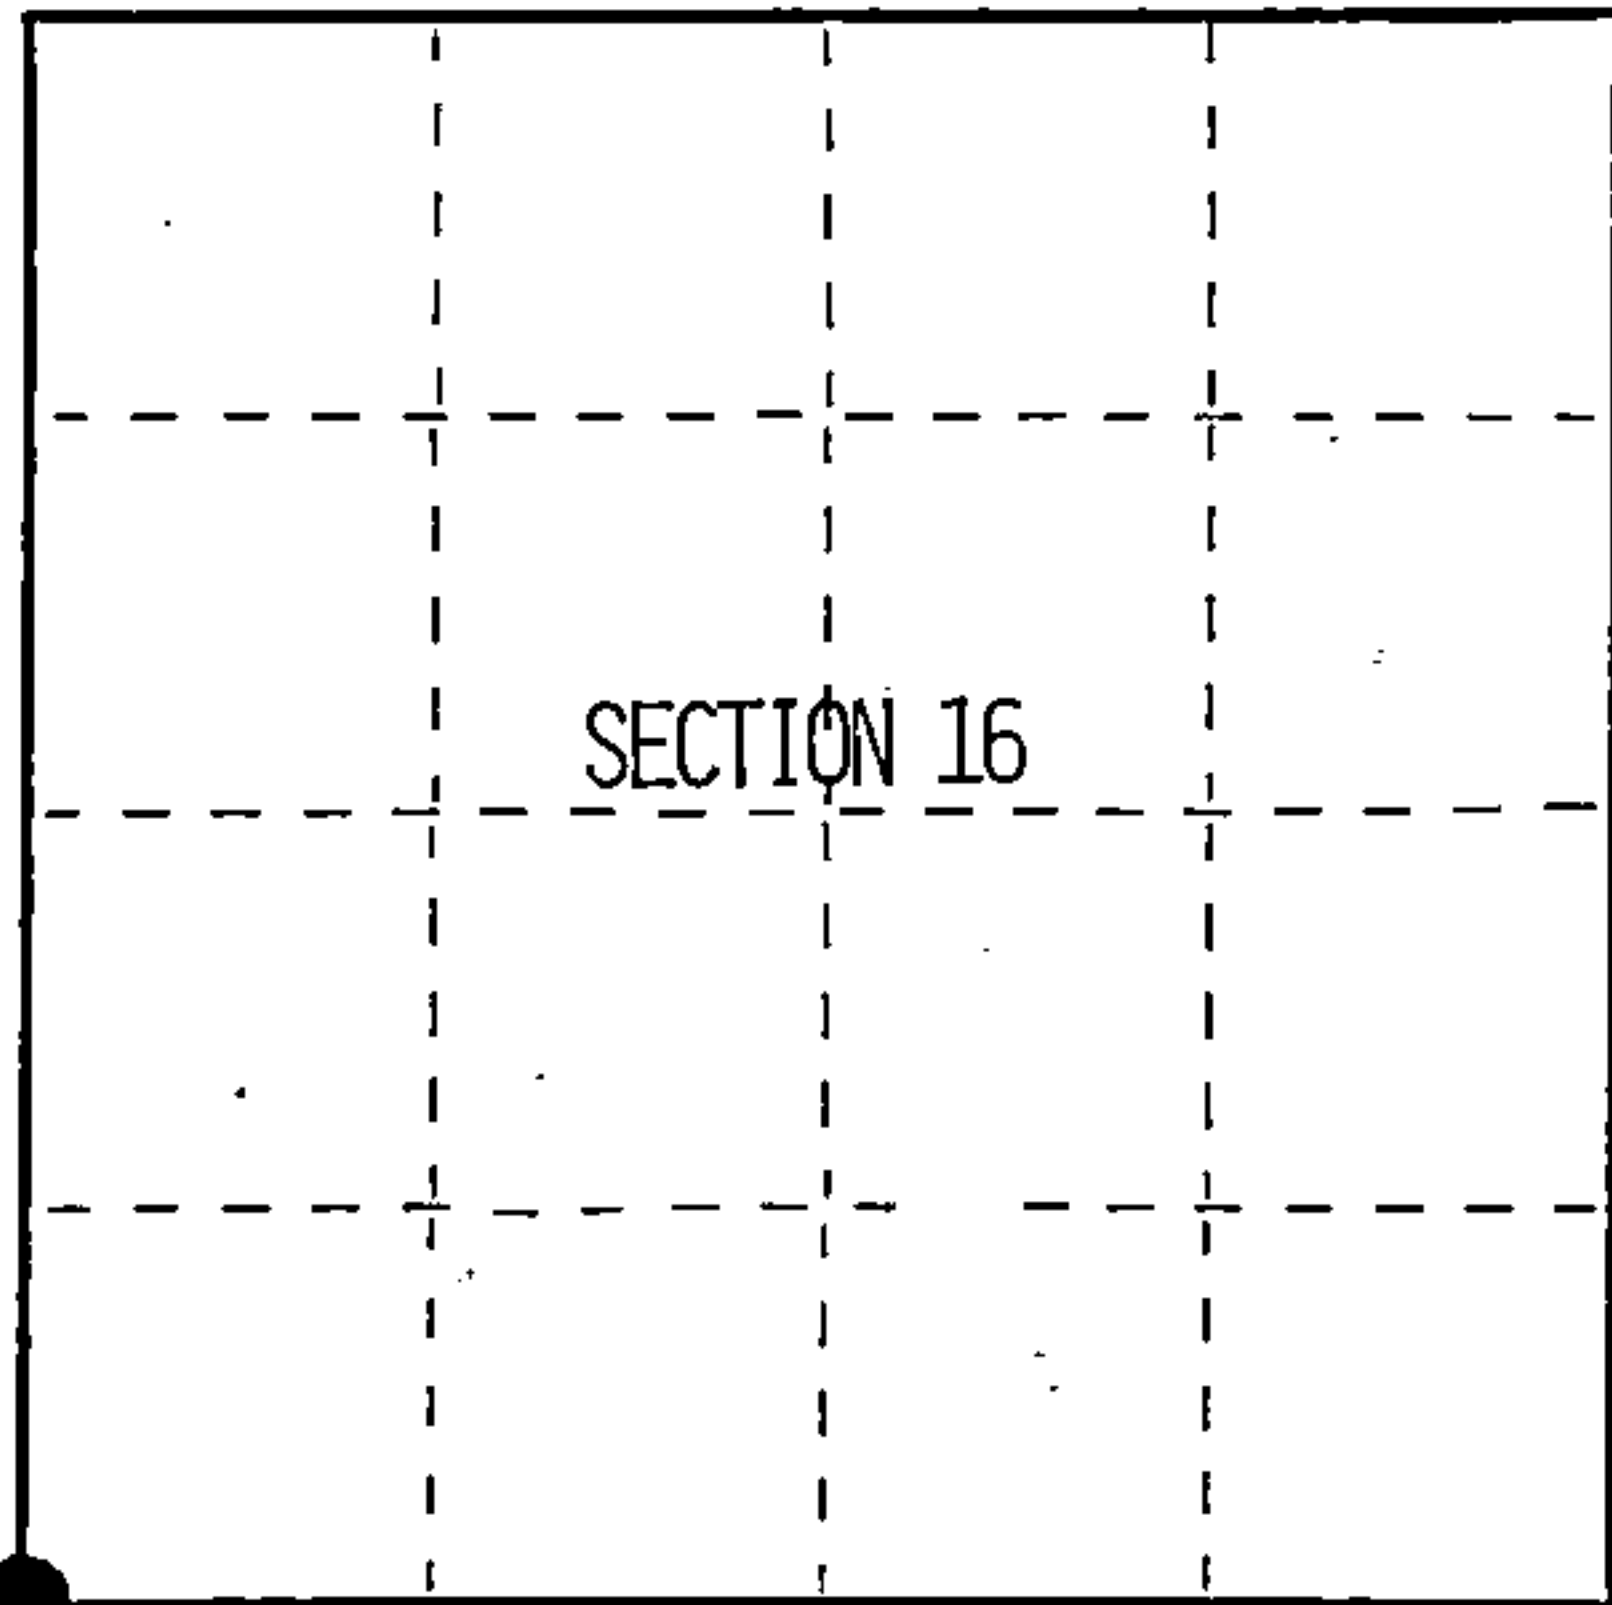

● = Corner monument restored.

FORM NO. 985-A



Stock No. 26273

156568

4391317000

