

CERTIFIED LAND CORNER RESTORATION

State of Wisconsin }
County of Forest } ss.

I William B. Cochrane, do hereby certify that on the 26th day of May, 19 82, I found evidence of the Northeast Section corner of Section 3 Township 40 North, Range 12 East, Fourth Principal Meridian, as described hereon; and that from this evidence I established a new monument and accessories as described hereon to perpetuate the original location of this corner:

Description of original monument and accessories and subsequent restorations:

North township line surveyed by Artemus Curtis in 1857
Dependent resurvey by Guy R. Veal in 1941
From remains of an original bearing tree, set 6" diameter concrete monument with brass cap marked T40N, R12E, S2, S3, 1941
From which the following bear:
Hemlock, 6", S12E, 83 lks.
Maple, 9", S72W, 108 lks.

Description of corner evidence found:


Monument as described and in place
Hemlock, 16", S12E, 83 lks.
Maple stump, S72W, 108 lks.

Description of monument and accessories I established to perpetuate the location of this corner:

Blazed and scribed the following new bearing trees:
Maple, 22", S26E, 49.72 ft.
Maple, 13", S15W, 36.17 ft.
Hemlock, 15", N77W, 57.50 ft.
Steel sign post, Southeast, 1.0 ft.



DOCUMENT NO.
124411

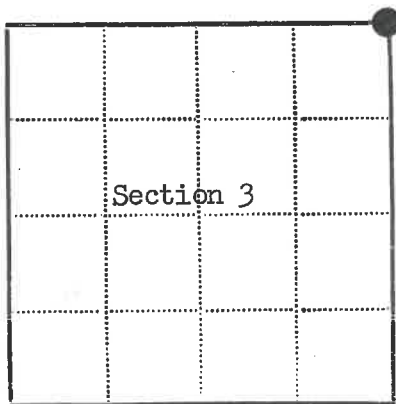

● - Corner monument restored
□ -

Resident witnesses.....

Dated at Hiles Wisconsin, this 21st day of July 19 82.

Signature William B. Cochrane Title Land Surveyor
(County Surveyor, Registered Land Surveyor, or other duly authorized official)

Surveyors Registration No. S-1107

Office of Register of Deeds County of Forest

I hereby certify that the within instrument was filed in this office for record on the 7th day of October 19 83, and was filed in Book No. Page No. of County Records.

Signature Eugene Stegany title Register of Deeds

Township 40 North, Range 12 East, Section 3, Index No. A-17, Page No.

44012034000

A 17