	- 1
Σ	Ş
È.	c
r weens	Ġ
C. Mills	_
ヹ	3
	- 2

-	
1707	
2	
STOCK	
"	

DOCUMENT NUMBER

Indev	No. A	11-12
muex	INU.Z.Z.	

State of Wisconsin ss.
County of Forest ss.
I Robert H. Winat , do hereby certify that on the 6th day of February , 19 85 , I found evidence of the meander corner of 4
Township40, North, Range 12 East, Fourth Principal Meridian as described hereon; and that from this evidence I established a new monument and accessories as described hereon to perpetuate the original location of this corner.
Resident witnesses:
Mike Stevens
Mike Lukasko

	KENTUCK LAKE	T4
1		74
	1 	_
	!!!!	
		-
1	† † † † † † † † † † † † † † † † † † †	
!		
i I		

O = Corner monument restored.

						mack mong
	Depende	of original corner establish ent resurvey by Guy te monument with a (R. Veal		6"x24"	
	BT's:	Hemlock Hemlock	11" 6"	S42°W N32°W	38 1ks. 56 1ks.	
	Found: Rotted	stump (Hemlock) Stump hole		N43°W N10°E	16 lks. 22 lks.	
		on of corner evidence fou G.L.O. monument. BT's:	nd:			
		Stump mound Stump (cut) Hemlock	14"	N46°W S42°W N32°W	11 feet (original) 25 feet 36.40 feet-set nail	in tree
	Descripti	on of monument and acce	essories I es	tablished to perpetu	ate the original location of	this corner.
	Blazed and scribed new BT's:					
N		Yellow Birch Sugar Maple Steel Sign Post	12 '' 5 ''	S27°E S25°W S2°E	21.03 feet to nail i 28.00 feet to nail i 1.62 feet	

(over)					
Dated at Rhinelander	, Wis., this 24th	day of June 1985	19		
Signature Rolet H. Min	Title R.L.S.	Registratio	on No.1040		
Signature Gounty Surveyor, Registered Land Surveyor, or other duly authorized official) Registration No. 1040					
Office of Register of Deeds, County of					
instrument was filed in this office for a	record on the Z4TN	day of JULY	10 83		


Ocul Ascheabreman (Register of Deeds)

7_____Deputy

Describe any material discrepancy between the location of the corner as restored or reestablished and the location of that corner as previously restored or reestablished by distance and direction. Show the discrepancy on the plan view drawing under (d), above. Show the distances between the corner as previously restored or reestablished and (1) the corner as restored or reestablished, and (2) to at least 2 of the witness monuments shown on the drawing in (d), above.

N/A.

- (f) Was the corner restored through acceptance of (1) an obliterated evidence location, or, (2) a found perpetuated location? Found perpetuated location.
- (g&h) Was the corner reestablished through lost corner proportionate methods? If so, show the method, including the directions and distances to other public land survey corners used as evidence or used for proportioning in determining the corner location?

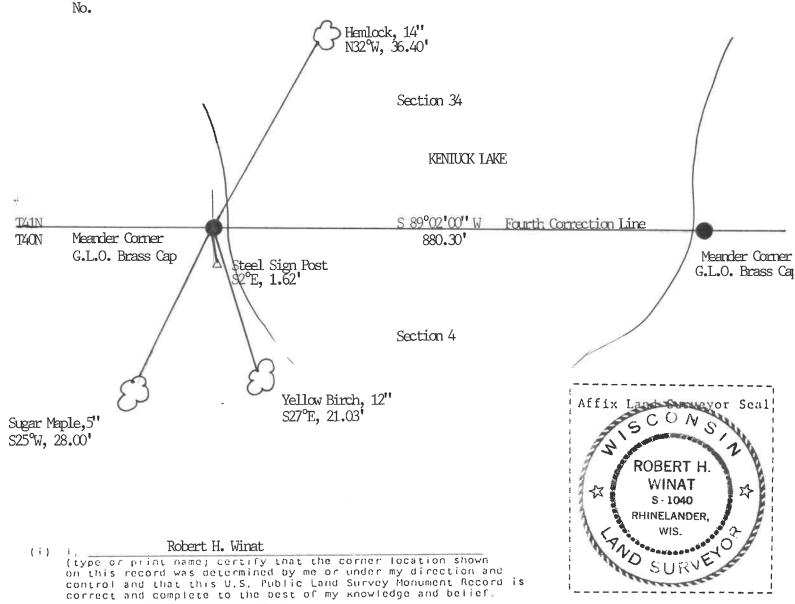

6/24/85 Date

det H. Winat

Signature