FORM NO. 985-A	H.C. Miller Company
FORM	H.C.Mille

128461
NUMBER
DOCUMENT

US	PUBLIC	LAND	SURVEY	MONUMENT	RECORD

		1		
Index	No.	H	//-	12

$\left.\begin{array}{ccc} \text{State of Wisconsin} \\ \text{County of} & Forest \end{array}\right\} \text{ss.}$	History of original corner establi Dependent resurvey by Guy concrete monument with a	y R. Veal in 1941. Set		NO. 7
I Robert H. Winat , do hereby certify that on the 6th day of February , 19 85 , I found evidence of the meander	BT's: Hemlock Hemlock	8" N403/4°E 14" S23½°E	77 lks. 31 lks.	
corner of 4	Found original remains:			
Township	Rotted Hemlock Stump Dead Hemlock	N60½°E 14" N18°W	12 lks. 44 lks.	
as described hereon; and that from this evidence I established a new monument and accessories as described hereon to perpetuate the original	Description of corner evidence for Found G.L.O. monument. Found BT's:	ound:		
location of this corner.	Hemlock Stump rema	ains with cedar intertw	vined. (original)	
Resident witnesses:	Hemlock Hemlock	21" S25°E 12" N44°E	20.30 feet (1941) 50.90 feet (1941)	
Mike Stevens	Set nail in BT's.			
Mike Lukasko				
	Description of monument and ac Blazed and scribed BT's:	ccessories I established to perp	petuate the original location of this corne	er.
33 34 TANN TAON		9" S21°W Southwest	35.74 feet to nail in tree. 1.00 feet	
	(over)			
	Date in Phinolande	or Wi- thin 2/th	day of June 1985	10
	Signature County Surveyor, Office of Register of Deeds, Countinstrument was filed in this office at 1:10 o'clock P M.	Title R.L.S. Registered Land Surveyor or other nty of Forest e for record on the 24 I.	Registration	1 No. 1040
	(Register	r of Deeds)		


O = Corner monument restored.

Denu

Describe any material discrepancy between the location of the corner as restored or reestablished and the location of that corner as previously restored or reestablished by distance and direction. Show the discrepancy on the plan view drawing under (d), above. Show the distances between the corner as previously restored or reestablished and (1) the corner as restored or reestablished, and (2) to at least 2 of the witness monuments shown on the drawing in (d), above. N/A.

(f) Was the corner restored through acceptance of (1) an obliterated evidence location, or, (2) a found perpetuated location? Found perpetuated location.

(g&h) Was the corner reestablished through lost corner proportionate methods? If so, show the method, including the directions and distances to other public land survey corners used as evidence or used for proportioning in determining the corner location?

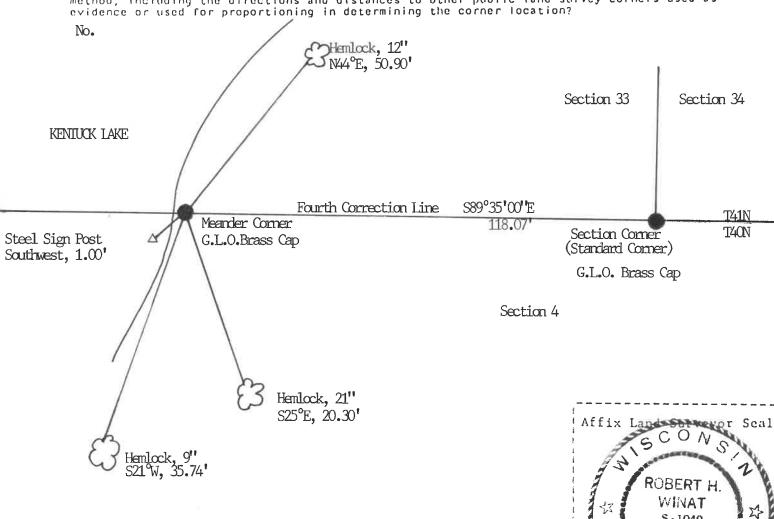

Robert H. Winat type or print name; certify that the corner location shown on this record was determined by me or under my direction and control and that this U.S. Public Land Survey Monument Record is correct and complete to the best of my knowledge and belief.

Sofet H. Signature

Affix Land Solveyor Scal S-1040 RHINELANDER, WIS. NO SURN