Index No. A - 7

Montante Company [77]	26273				
	No.				
	Stock				

128459

DOCUMENT NUMBER

IIS	PUBLIC	LAND	SURVEY	MONUMENT	RECORD
U. O.	FUDLIC	LAND	SOLVE	MOMORIFIA	NECOND

U _a S _a	PUI
State of Wisconsin ss.	
County of Forest	
I Robert H. Winat , do hereby certify that on the 22nd day of January , 19.85 , I found evidence of the quarter corner of 5. Township 40 , North, Range 12 East Fourth Principal Meridian, as described hereon; and that from this evidence I established a new monument and accessories as described hereon to perpetuate the original location of this corner.	
Resident witnesses:	
Mike Stevens	
Mike Lukasko	

	,				
-	+	_	_	 -	
	ı			- 1	
	1			- 0	
	1				
	1	_	_	 _	
	ı				
	ļ				
	1				
	1				
	1				

O = Corner monument restored.

History of original corner establishment:

Dependent resurvey in 1941 by Guy R. Veal, set a 6"x24" concrete monument with a G.L.O. brass cap.

BT's: Maple 4" S72½°E 34 lks. Ash 4" S59½°W 51½ lks.

Description of corner evidence found:

Found G.L.O. monument and brass cap.

BT's: Maple 4" S65½°E 22.50 feet (dead)
Ash 9" S64°W 33.90 feet

Description of monument and accessories I established to perpetuate the original location of this corner. Blazed and scribed new BT's:


Sugar Maple 14" S88½°E 82.26 feet
Sugar Maple 10" N38½°E 69.04 feet all to nail in tree
Sugar Maple 8" N45°W 15.19 feet
Steel Sign Post South 0.40 feet

(over)

Dated at Khinelander	Wis., this	14	day of	June	1900	, 19
Signature Robert H. Winds (XXXXXXXXXXXXXXXXXXXXXXXXXXXXXXXXXXXX	Title I Land Survey	R.L.S.)) Dalay Charak Birasa (Cara Charac Chara	R	egistration N	o. 1040
Office of Register of Deeds, County of	For rd on the	est 24th	day of	July July	y certify tha	t the within
at 1:10 o'clock P. M. M. Hard Ascheroft	enaer					
(Register of Deeds)						
_		D				

Describe any material discrepancy between the location of the corner as restored or reestablished and the location of that corner as previously restored or reestablished by distance and direction. Show the discrepancy on the plan view drawing under (d), above. Show the distances between the corner as previously restored or reestablished and (1) the corner as restored or reestablished, and (2) to at least 2 of the witness monuments shown on the drawing in (d), above. (e) N/A.

- (f) Was the corner restored through acceptance of (1) an obliterated evidence location, or, (2) a found perpetuated location? Found perpetuated location.
- (g&h) Was the corner reestablished through lost corner proportionate methods? If so, show the method, including the directions and distances to other public land survey corners used as evidence or used for proportioning in determining the corner location? No.

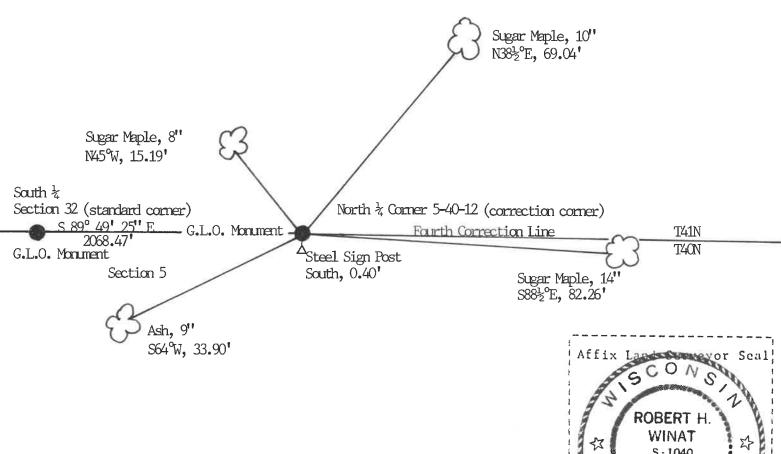

Robert H. Winat

(type or print name) certify that the corner location shown on this record was determined by me or under my direction and control and that this U.S. Public Land Survey Monument Record is correct and complete to the best of my knowledge and belief.

del H. Wm Signature

S-1040 RHINELANDER, WIS. PNO SURVE