

CERTIFIED LAND CORNER RESTORATION

State of Wisconsin }
County of Forest } ss.

I William B. Cochrane, do hereby certify that on the 4th day of February, 1976, I found evidence of the Southeast Section corner of Section 15 Township 40 North, Range 12 East, Fourth Principal Meridian, as described hereon; and that from this evidence I established a new monument and accessories as described hereon to perpetuate the original location of this corner:

Description of original monument and accessories and subsequent restorations:

Dependent resurvey in 1941 by Guy R. Veal
From the remains of original evidence, set a concrete monument, 6 ins. diameter, 24 ins. long, 18 ins. in the ground with a brass cap stamped:
T40N, R12E, S14, S15, S22, S23, 1941 From which the following bear:
Yellow Birch, 9 ins., N76° 30'E, 37.5 lks.
Yellow Birch, 6 ins., S45° 15'E, 43.5 lks.
W. Pine, 5 ins. S66° 15'W, 33.0 lks.
Yellow Birch, 8 ins., N84°W, 56.5 lks.


Description of corner evidence found:

Monument as described above
Yellow Birch, 12 ins., N76°E, 37.5 lks.
Yellow Birch, 6 ins., S45°E, 43.5 lks.
W. Pine, 8 ins., S66°W, 33 lks.
Yellow Birch, 8 ins., N84°W, 56.5 lks. (dead snag)

Description of monument and accessories I established to perpetuate the location of this corner:

Blazed and scribed the following new bearing tree:

Hemlock, 8 ins., N88°W, 24.48 feet
Set a steel sign post, north of the monument, 0.50 ft.

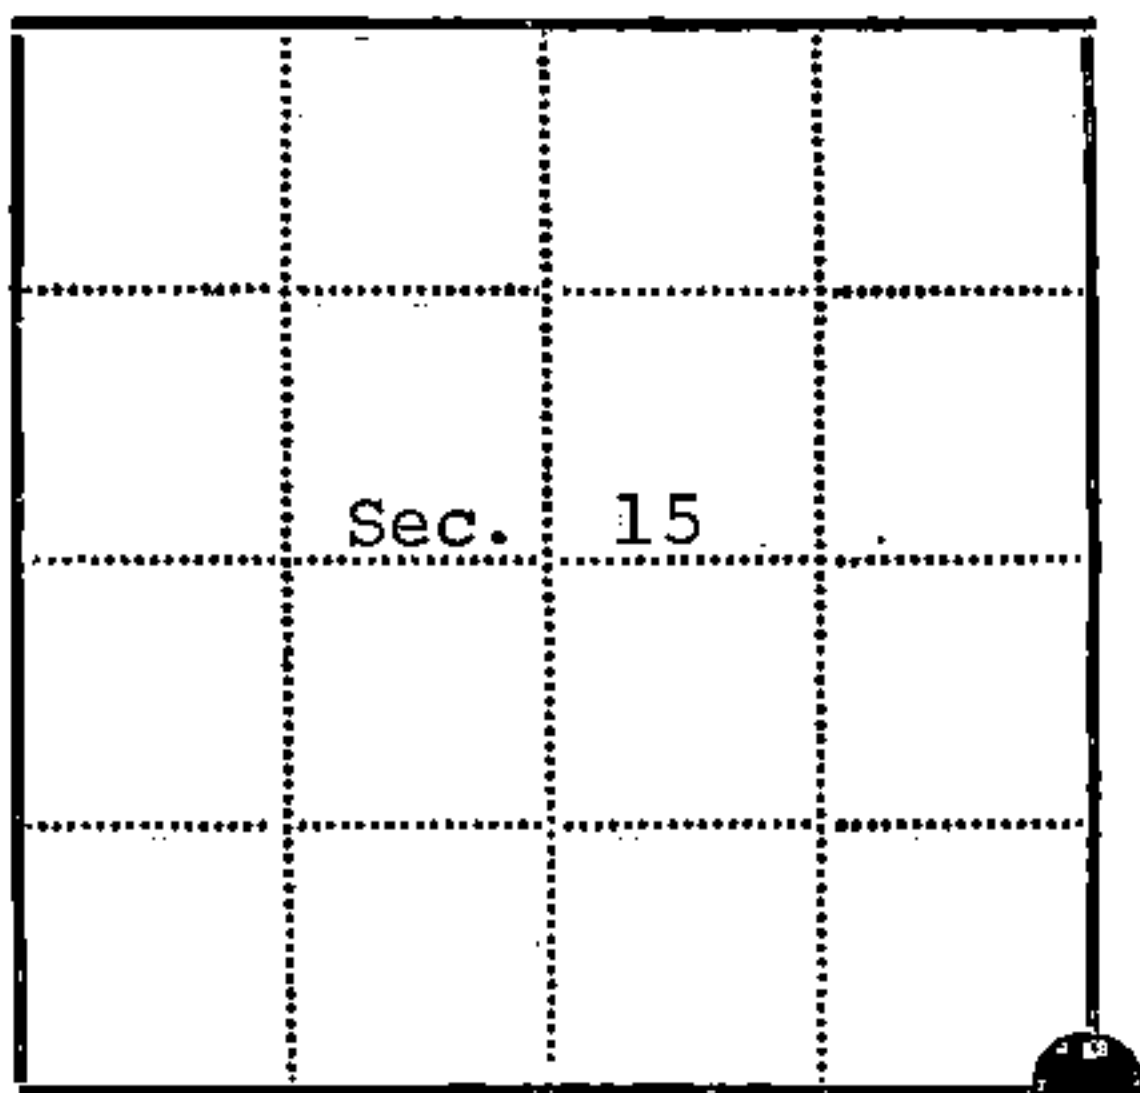

● - Corner monument restored
□ -

Resident witnesses.....

Dated at Three Lakes Wisconsin, this 16th day of April 1976.

Signature William B. Cochrane Title Survey Technician
(County Surveyor, Registered Land Surveyor, or other duly authorized official)

Surveyors Registration No. S-1107 DOCUMENT NUMBER 109613

Office of Register of Deeds County of Forest

I hereby certify that the within instrument was filed in this office for record on the 2nd day of July 1976, and was filed in Book No. Page No. of County Records.

Signature Eugene Stutz Title Register of Deeds

Township 40 North, Range 12 East, Section 15, Index No. N-17, Page No.

44012150000

N17