


CERTIFIED LAND CORNER RESTORATION

Index No. N-9
N 9

State of Wisconsin }
County of Forest } ss.

I Jean F. Resvick, do hereby certify that on the 31st day of May, 1963, I found evidence of the Section corner of Sections 16, 17, 20 & 21 Township 40, North, Range 12 East, Fourth Principal Meridian, as described hereon; and that from this evidence I established a new ~~monument~~ and accessories as described hereon to perpetuate the ~~original~~ location of this corner.

Resident witnesses:

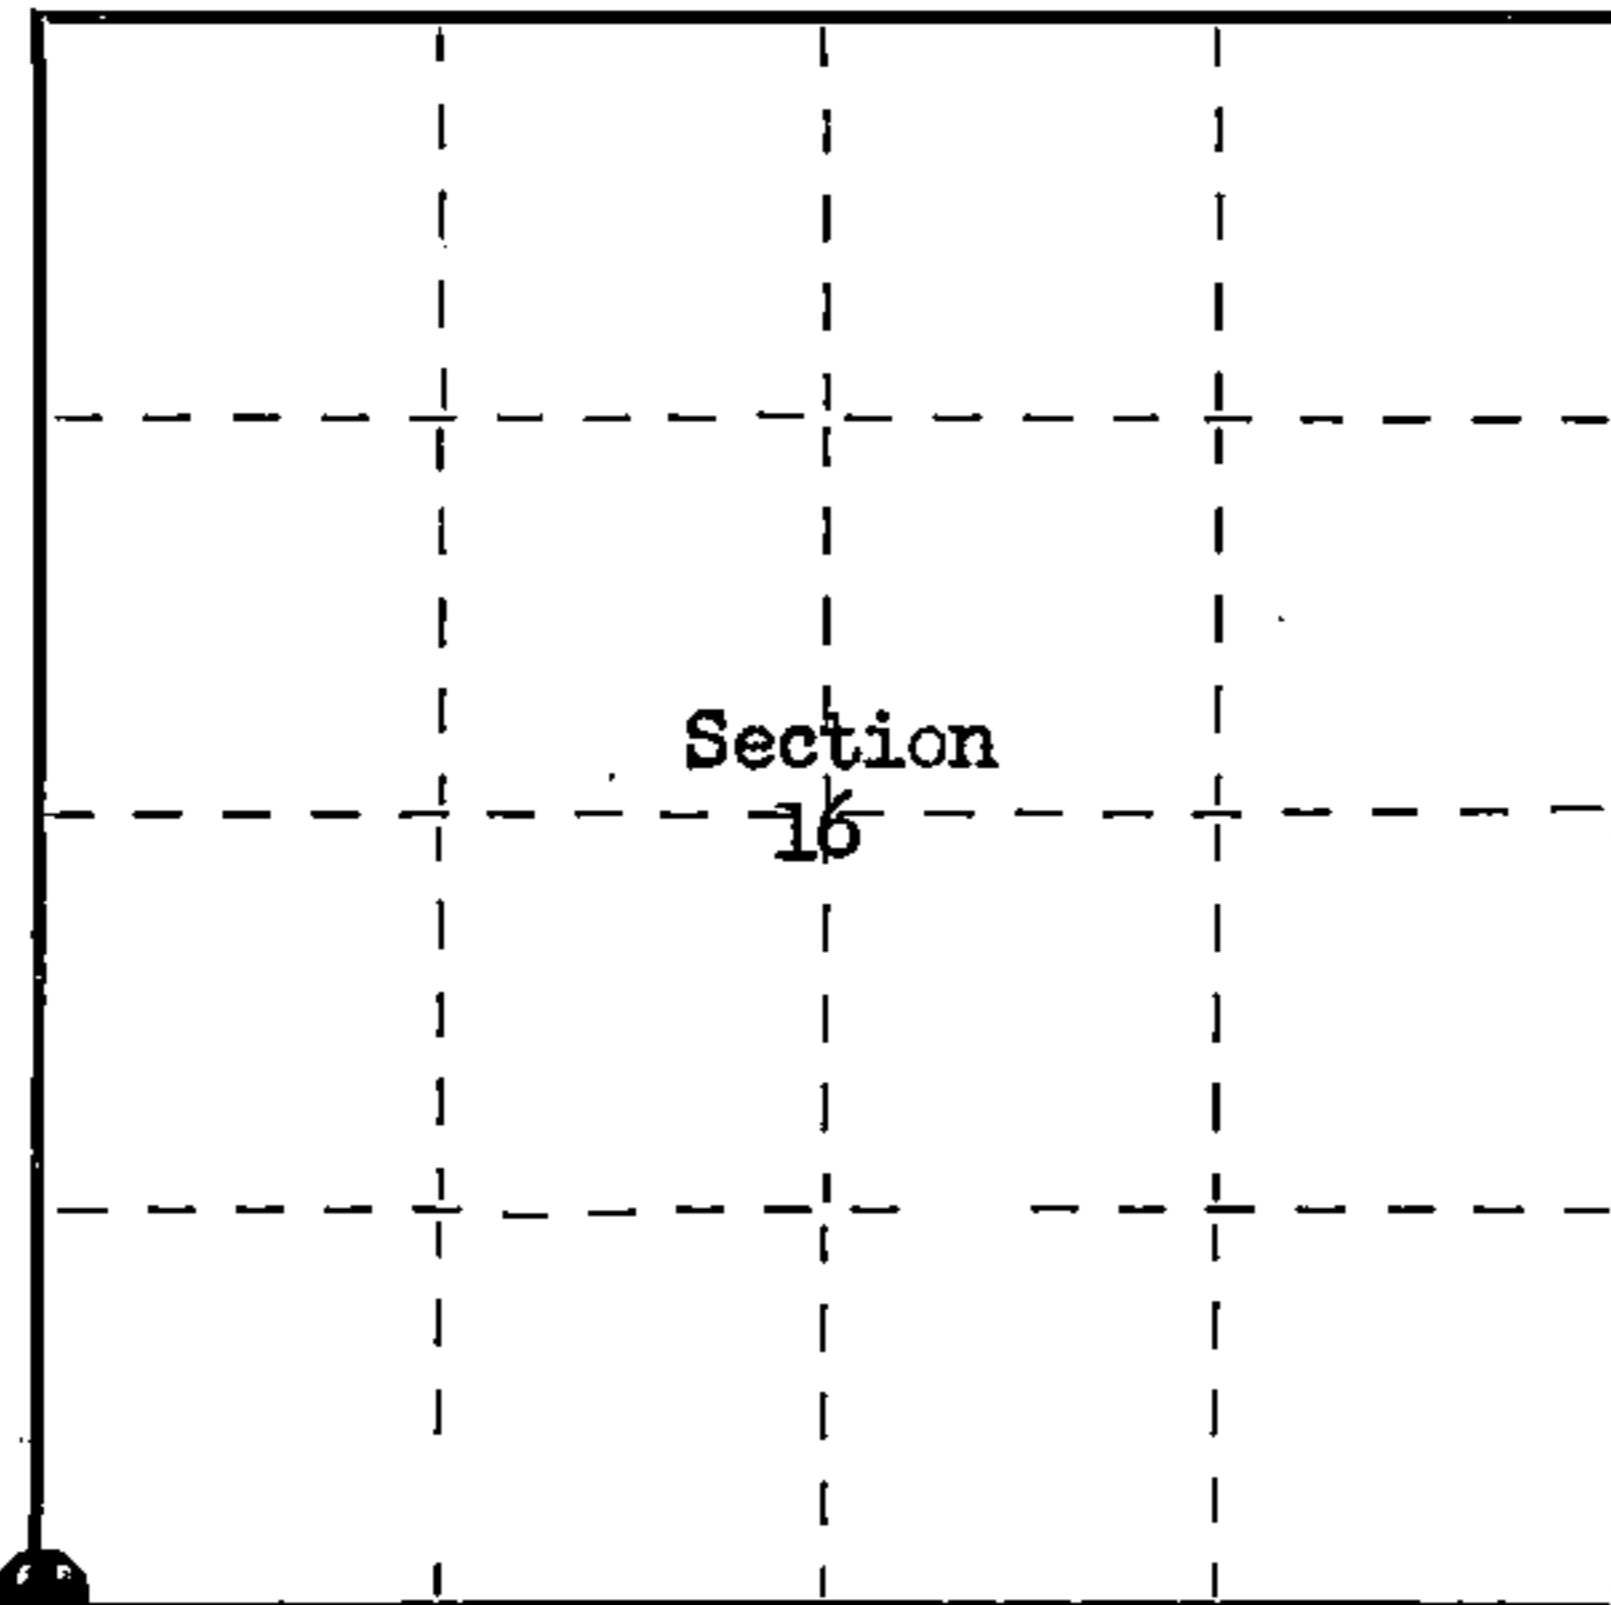

○ = Corner monument restored.

History of original corner establishment:

Surveyed in 1859 by Wm. E. Daugherty. Dependent Resurvey in 1941 by Guy R. Veal. Set concrete monument, 2 ft. long, 6 in. diam., with iron post, 22 in. long, 1 in. diam., encased therein with brass cap marked:



From which: W. birch 7", bears, N62°E, 33½ lks.
W. birch 6", bears, S68°30'E, 51½ lks.
W. birch 8", bears, S50°W, 30 lks.
W. birch 6", bears, N56°W, 36 lks.

Description of corner evidence found:

Monument as described:

W. birch stump, cut by Power Co., scribe showing, N69°30'E, 21.90 ft.
W. birch stump, cut by Power Co., scribe showing, S69°30'E, 35.50 ft.
W. birch, 12", S50°W, 20.25 ft.
W. birch, 8", N56°W, 23.35 ft.

Description of ~~monument~~ and accessories I established to perpetuate the ~~original~~ location of this corner. Blazed and scribed the following new bearing trees:

Balsam 5", S57°E, 54.40 ft. (82.42 lks.)
Spruce 5", S7°W, 30.30 ft. (45.91 lks.)
Spruce 9", N72°30'W, 24.20 ft. (36.67 lks.)
W. birch 7", N28°E, 40.75 ft. (61.74 lks.)
Power pole number 4012-16-11, S50°E, 28.85 ft. (43.71 lks.)

Dated at Rhineland, Wis., this 16th day of August, 1963.

Signature Jean F. Resvick Title Cadastral Surveyor Registration No. S-802
(County Surveyor, Registered Land Surveyor, or other duly authorized official)

Office of Register of Deeds, County of Forest, I hereby certify that the within instrument was filed in this office for record on the 4 day of November, 1963 at 9:00 o'clock A. M.

Inna Peterson
(Register of Deeds)

87829

By _____ Deputy

FORM 985 H. C. MILLER CO., MILWAUKEE

44012170000