

CERTIFIED LAND CORNER RESTORATION

State of Wisconsin }
County of Forest } ss.

I William B. Cochrane, do hereby certify that on the 17th day of January, 1975, I found evidence of the East Quarter corner of Section 23 Township 40 North, Range 12 East, Fourth Principal Meridian, as described hereon; and that from this evidence I established a new monument and accessories as described hereon to perpetuate the original location of this corner:

Description of original monument and accessories and subsequent restorations:

Dependent resurvey of 1941 by Guy R. Veal
At proportionate distance set an iron post 3 feet long, 2 ins. diameter, 27 ins. in the ground with a brass cap marked: 1/4, S23, S24, 1941 From which: Poplar, 6" bears N68° 15'E, 14 lks., Poplar 6" bears N26° 30'W, 41 lks.


Description of corner evidence found:

Monument as described above and in place.
Aspen snag, N68°E, 14 lks.
No evidence of the other aspen bearing tree.

Description of monument and accessories I established to perpetuate the location of this corner:

I blazed and scribed the following new bearing trees:

W. Spruce, 13", bears N66°E, 23.14 feet
W. Spruce, 5", bears N45°W, 55.44 feet
Set a steel sign post west of the monument, 0.50 feet

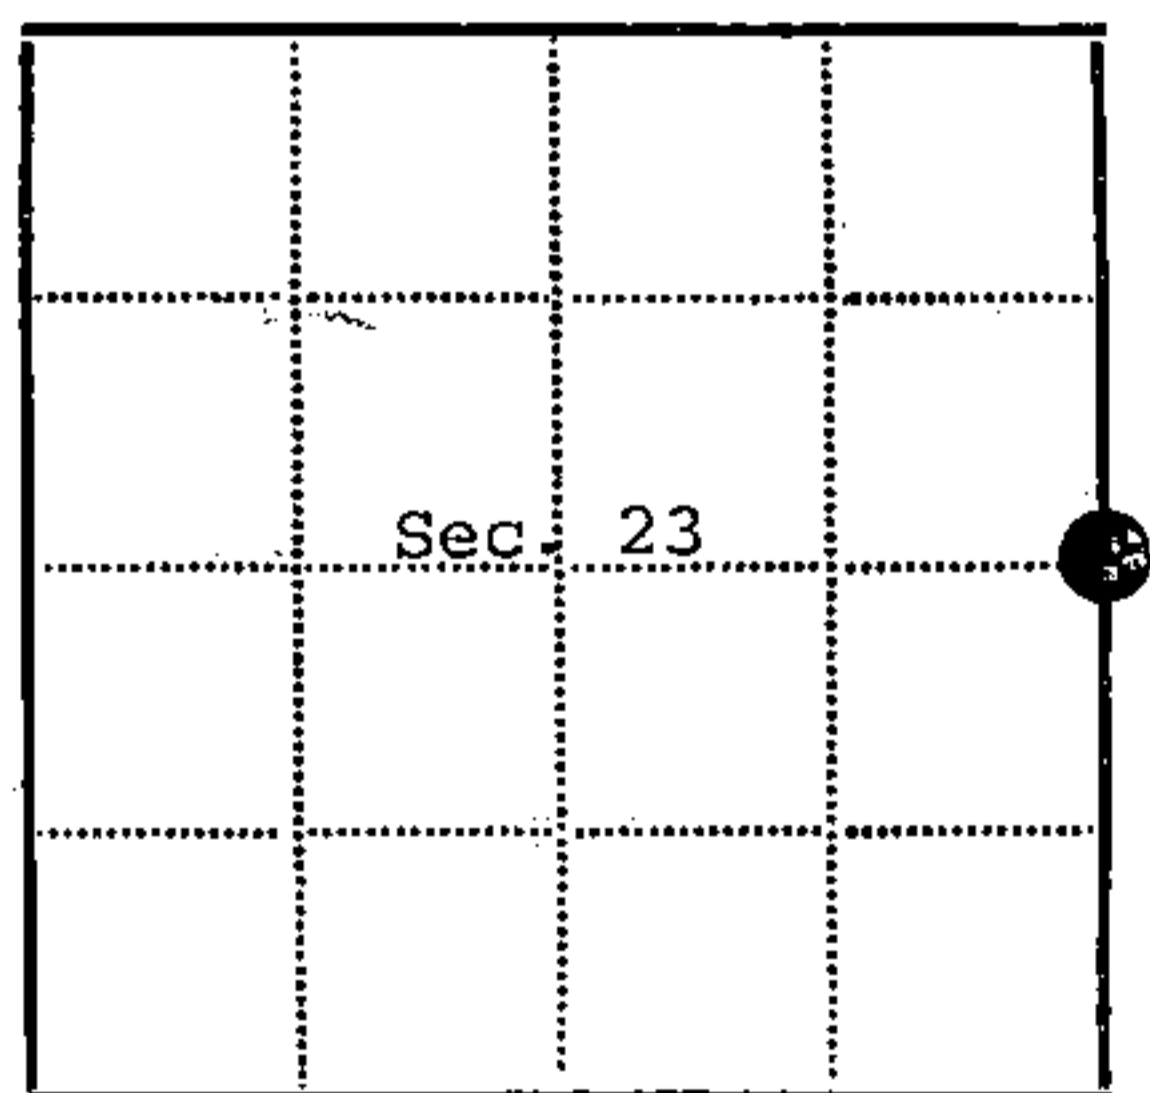

● = Corner monument restored
□ =

Resident witnesses.....

Dated at Three Lakes Wisconsin, this 20 day of January 1975.

Signature *William B. Cochrane* Title Land Surveyor
(County Surveyor, Registered Land Surveyor, or other duly authorized official)

Surveyors Registration No. S-1107 Document Number 106878

Office of Register of Deeds County of Forest

I hereby certify that the within instrument was filed in this office for record on the 31st day of March 1975, and was filed in Book No. Corner Restorations Page No. P-21 of County Records.

Signature *Eugene Stutz* Title Register of Deeds

Township 40 North, Range 12 East, Section 23, Index No. P-21, Page No.

44012232000

P21