

CERTIFIED LAND CORNER RESTORATION

State of Wisconsin }
County of Forest } ss.

I, Jean F. Resvick, do hereby certify that on the 27th day of August, 1973, I found evidence of the East Quarter corner of Section 12 Township 40 North, Range 13 East, Fourth Principal Meridian, as described hereon; and that from this evidence I established a new monument and accessories as described hereon to perpetuate the original location of this corner:

Description of original monument and accessories and subsequent restorations:

Surveyed in 1857 by Alfred Millard
40.00 chains North between Sections 7 & 12
Set Post
Cedar 6, N67E, 9 lks
Hemlock 12, S85W, 12 lks
3.0 chains North enter swamp NE & SW
8.25 chains North stream 20 lks wide runs NW

Description of corner evidence found:



Chained South 40 chains from approximate Sec. corner of 1, 6, 7 & 12
Found old scribed post about 40 or 50 years old.
North 3 chains enter swamp bears NE & SW.
Water level too high in swamp to check stream call.
Fallen cedar B.T. of local origin, has slid down hill after falling.

Description of monument and accessories I established to perpetuate the location of this corner:

I accept the scribed post as the best available evidence and replace the post with a 2 inch inside diameter, galvanized iron pipe, 3 ft long, filled with concrete with brass cap stamped T40N, R13E, R14E, 1/4, S12, S7, 1973, S-802.

Blazed and scribe the following new bearing trees.

Spruce 6, N5E, 10.69 feet.
Balsam 6, S41W, 1.55 feet.

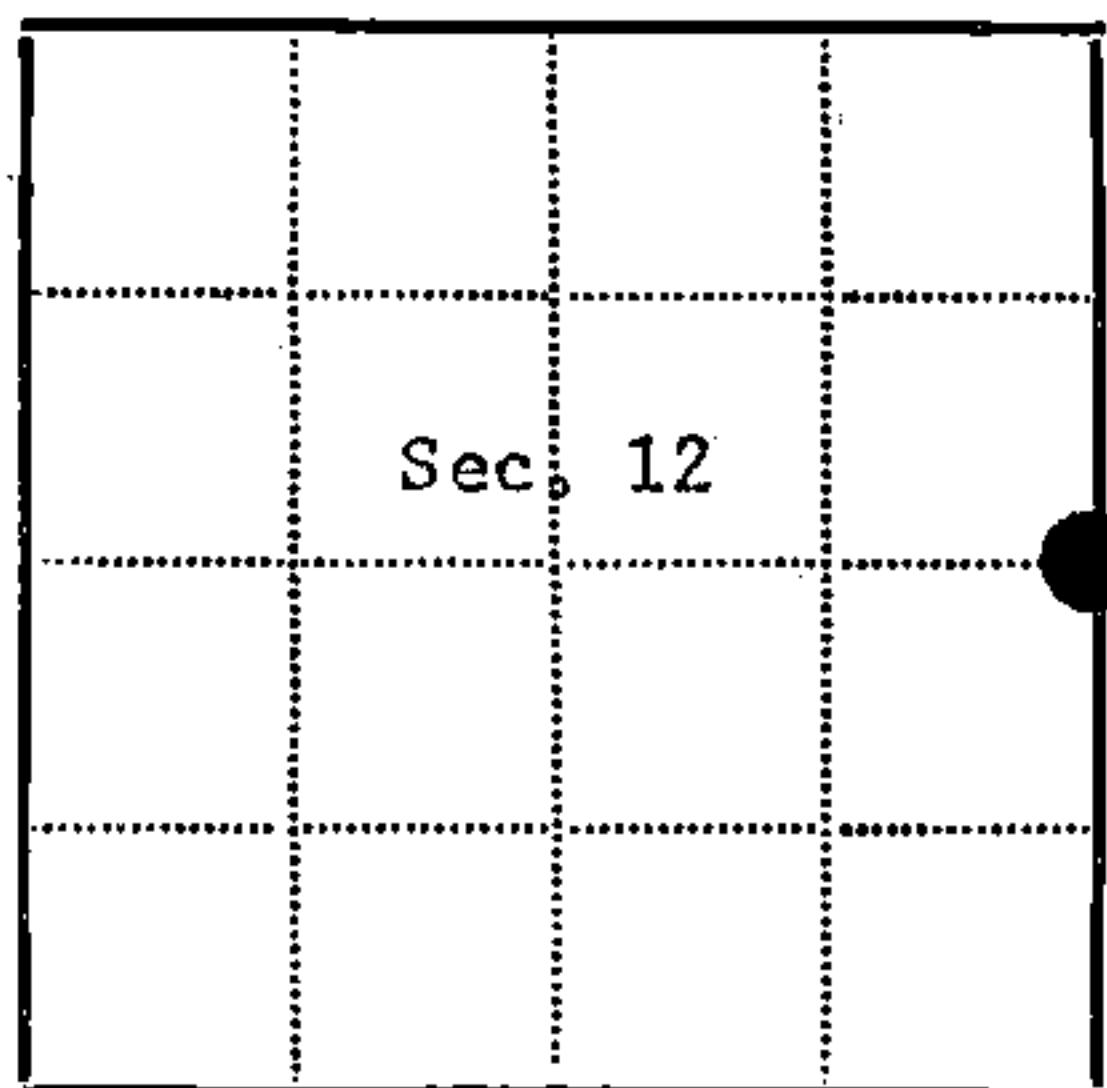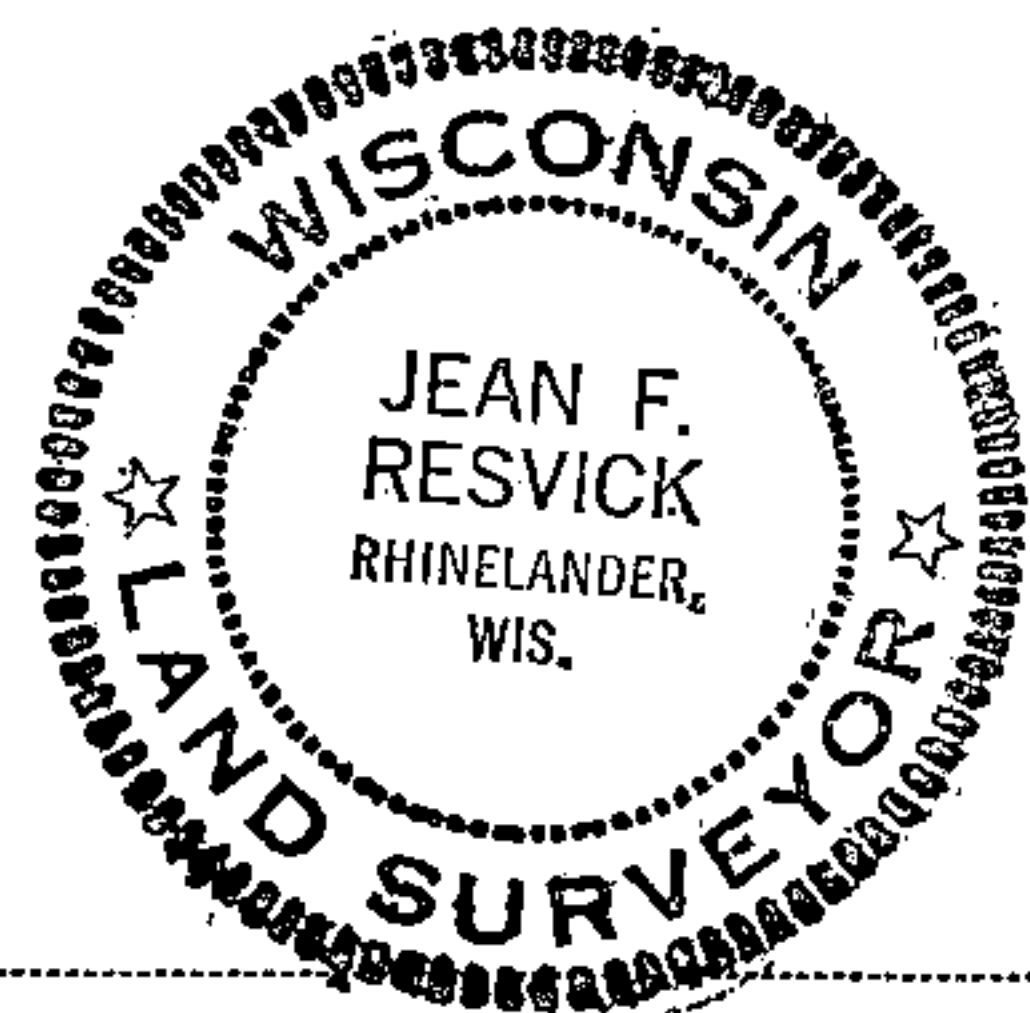

● = Corner monument restored
□ =

Resident witnesses.....

Dated at Rhinelander Wisconsin, this 30th day of Aug 1973.

Signature *Jean F. Resvick* Title Land Surveyor
(County Surveyor, Registered Land Surveyor, or other duly authorized official)

Surveyors Registration No. 5-802 DOCUMENT NUMBER 104453

Office of Register of Deeds County of Forest

I hereby certify that the within instrument was filed in this office for record on the 13th day of November 1973, and was filed in Book No. Corner Restorations Page No. G-25 of County Records.

Signature *Eugene Staszny* Title Register of Deeds

Township 40 North, Range 13 East, Section 12, Index No. G-25, Page No.