

U.S. PUBLIC LAND SURVEY MONUMENT RECORD

Index No. N-23

State of Wisconsin }
County of Forest } ss.

I, William B. Cochran, do hereby certify that on the 13th day of August, 1991, I found evidence of the North Quarter corner of Section 24 Township 40 North, Range 13 East, Fourth Principal Meridian, as described hereon; and that from this evidence I established a new monument and accessories as described hereon to perpetuate the original location of this corner.

Resident witnesses:

History of original corner establishment:

Original Government Survey in 1865 by William E. Daugherty. West corrected between Sections 13 and 24, at 39.81 chains, set Quarter Section Post, from which the following bear;

| | | | |
|---------|-----|-------|---------|
| Sugar | 12" | N41°W | 18 lks. |
| Hemlock | 15" | S56°E | 11 lks. |


Description of corner evidence found:

No corner evidence was recovered.

I re-established the corner position at mid-point and on line between the Northeast and Northwest Section Corners of Section 24.

Description of monument and accessories I established to perpetuate the original location of this corner. At the corner position, set a 2½ inch diameter aluminum pipe monument, 3 feet long, 2½ feet in the ground, with an aluminum cap stamped; T40N R13E, 1/4, S13, S24 1991, S-1107. From which the following new blazed and scribed bearing trees bear;

| | | | |
|----------------------|----|-------|-----------|
| B. Ash | 7" | S52°E | 8.97 feet |
| Spruce | 9" | S26°W | 9.12 feet |
| Set- Steel Sign Post | | SE | 0.50 feet |

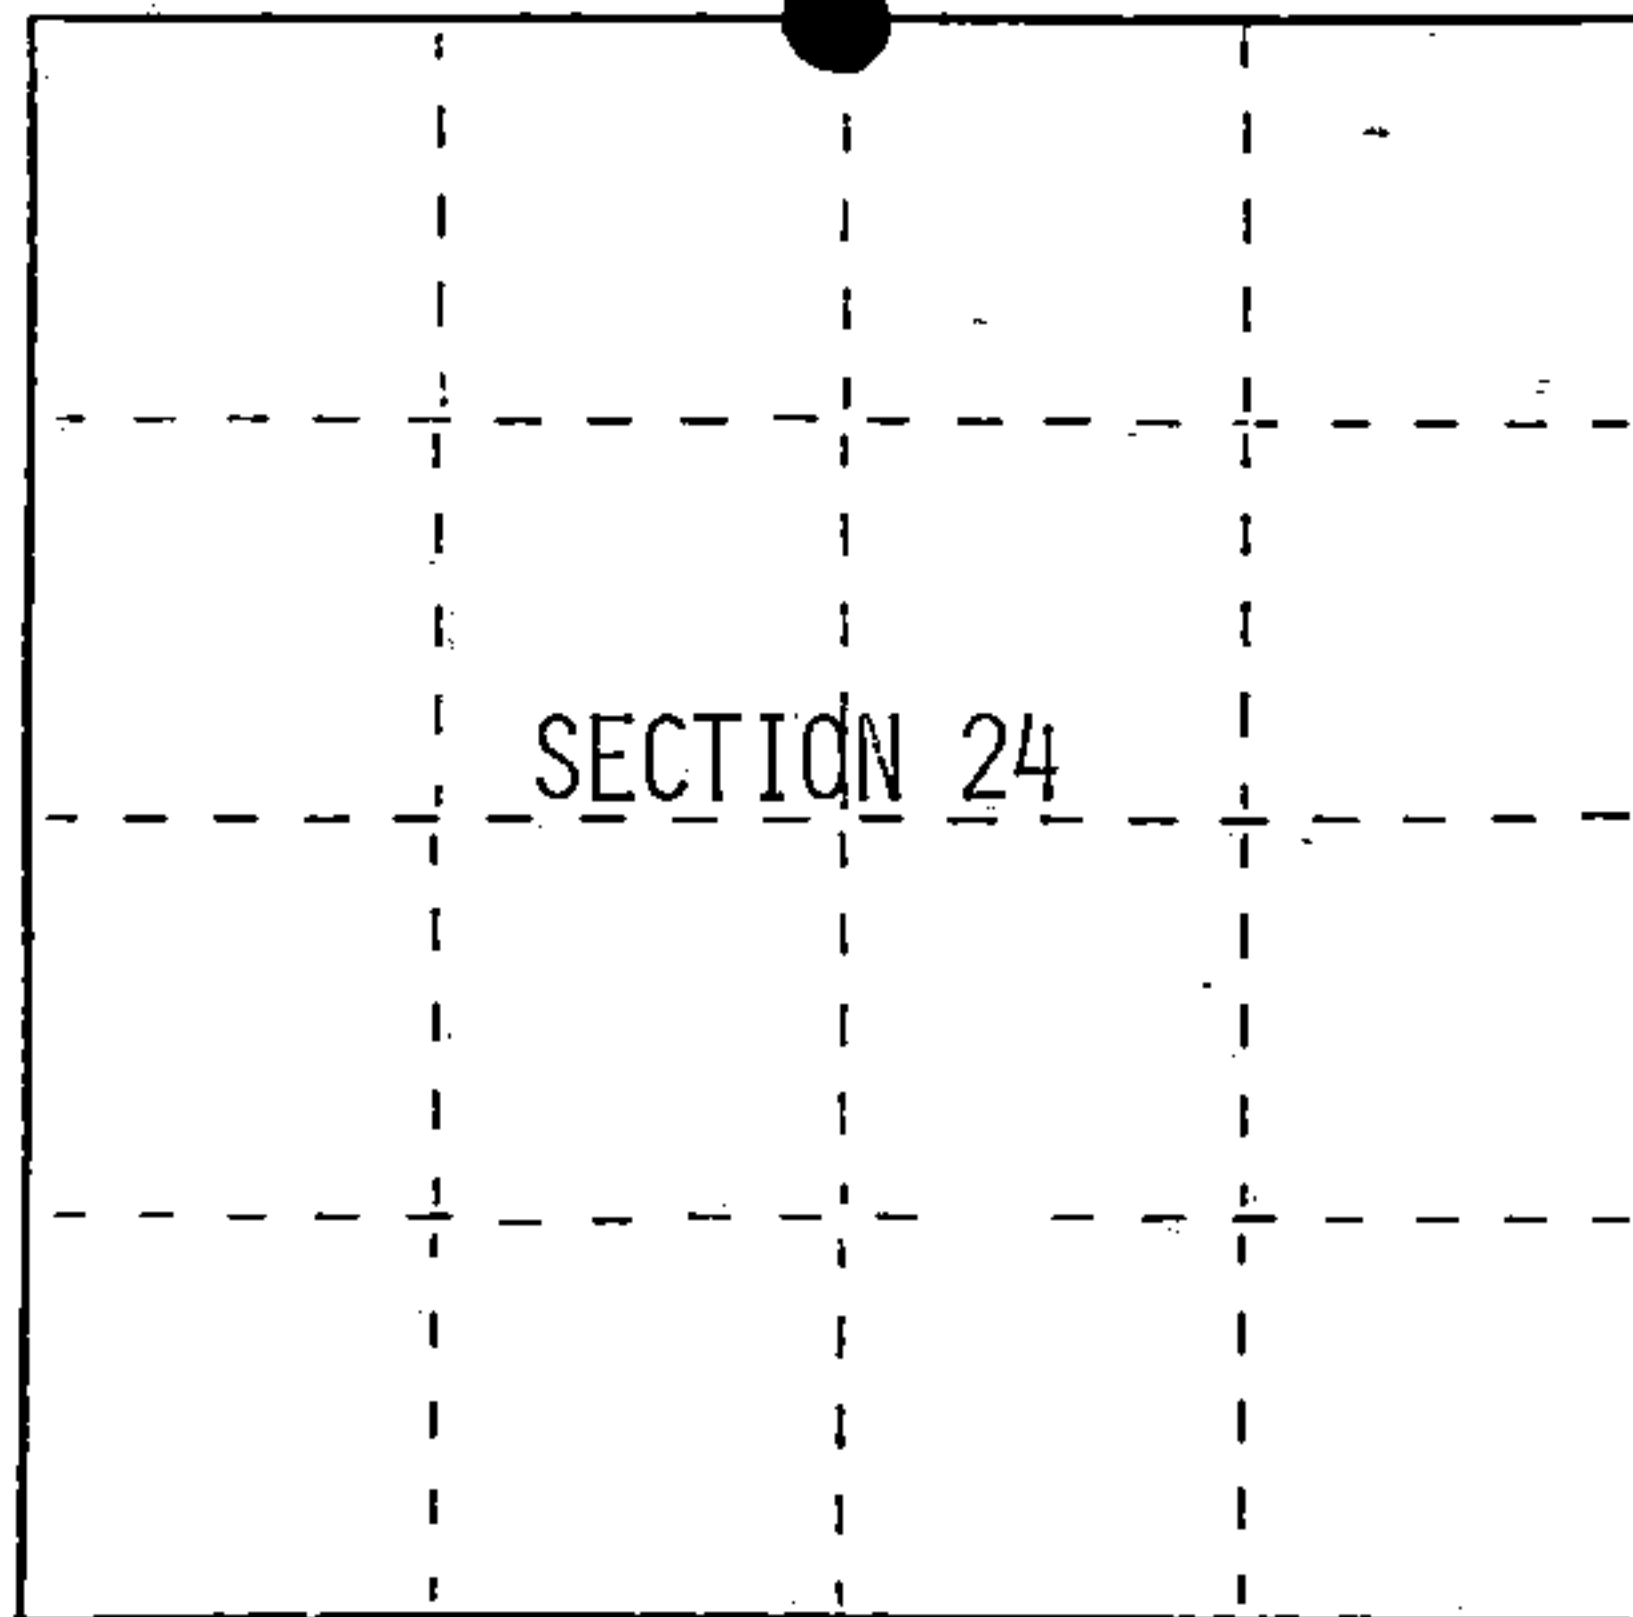

● = Corner monument restored.

Dated at Hiles, Wis., this 19th day of February, 19 92

Signature *William B. Cochran* Title Land Surveyor Registration No. S-1107
(County Surveyor, Registered Land Surveyor, or other duly authorized official)

Office of Register of Deeds, County of Forest, I hereby certify that the within instrument was filed in this office for record on the 31st day of August, 19 92 at 10:15 o'clock A. M.

Paul Ackerman
(Register of Deeds)

By _____ Deputy

FORM IND. 9885-A
THE STATE OF WISCONSIN
DEPARTMENT OF REVENUE

Stock No. 26273
DOCUMENT NUMBER
145368

4401313 0020

