

CERTIFIED LAND CORNER RESTORATION

State of Wisconsin

County of Forest

ss.

I, Jean F. Resvick, do hereby certify that on the 11th day of January, 1975, I found evidence of the west quarter corner of Section 17, Township 40 North, Range 13 East, Fourth Principal Meridian, as described hereon; and that from this evidence I established a new monument and accessories as described hereon to perpetuate the original location of this corner:

Description of original monument and accessories and subsequent restorations: Surveyed in 1865 by William E. Daugherty. 40.00 chains north between Sections 17 and 18, set post Tamarack 10, N51E, 6 lks Spruce 10, S63W, 23 lks


18.00 chains North, leave cedar and tamarack, swamp bears NE SW 22.00 chains South, creek 50 lks wide runs east

Description of corner evidence found:

4x4x3 cedar post Remains of tamarack B.T. with scribing visible, N50E, 4.0 feet Decayed remains of spruce S63W, 14.8 feet Forest Service location poster, dated 1939, bears N55E, 9.5 feet from post

Description of monument and accessories I established to perpetuate the location of this corner:

At record bearing and distance from original bearing trees, set 2 inch inside diameter galvanized iron pipe 5 feet long, filled with concrete, 2 inches above ground, with brass cap stamped: T40N, R13E, 1/4, S18, S17, 1975, S-802 Blazed and scribed the following new bearing trees: Cedar 12, bears N88E, 10.16 ft. Cedar 7, bears N29W, 17.60 ft. Set steel sign post 0.5 feet NE of monument

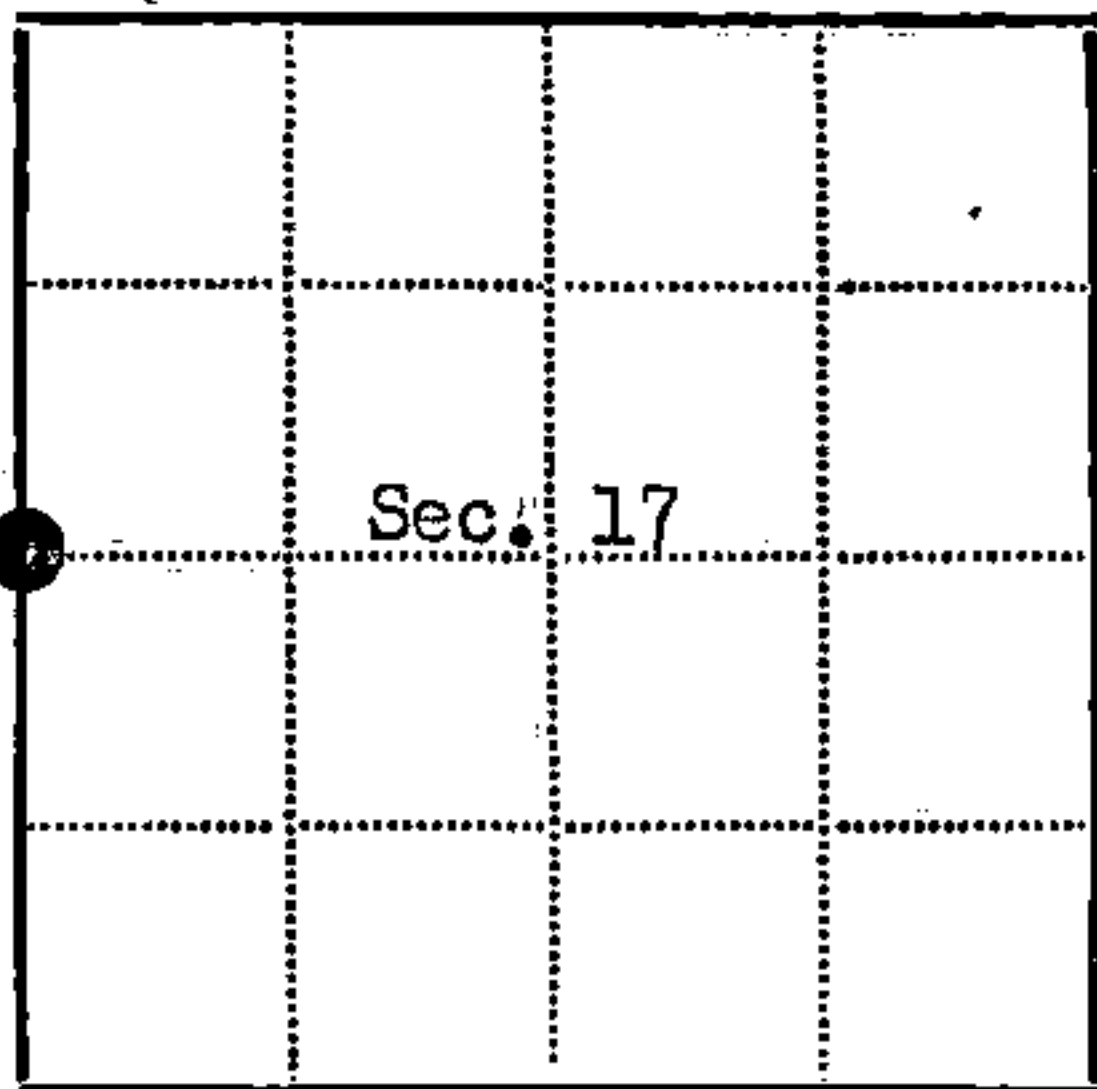

Corner monument restored

Resident witnesses

Dated at Rhinelander Wisconsin, this 20 day of March 1975

Signature Jean F. Resvick Title Land Surveyor (County Surveyor, Registered Land Surveyor, or other duly authorized official)

Surveyors Registration No. S-802 Document Number 106880

Office of Register of Deeds County of Forest

I hereby certify that the within instrument was filed in this office for record on the 31st day of March 1975, and was filed in Book No. Restorations Page No. 1-5 of County Records.

Signature Eugene Stutzman Title Register of Deeds

Township 40 North, Range 13 East, Section 17, Index No. 1-5, Page No.