

CERTIFIED LAND CORNER RESTORATION


83250

Index No. 19 R13

State of Wisconsin }
County of Forest } ss.

I Robert E. Badow, do hereby certify that on the 12th day of November, 1959, I found evidence of the South-West corner of Section 22 Township 40 North, Range 13 East, Fourth Principal Meridian, as described hereon; and that from this evidence I established a new monument and accessories as described hereon to perpetuate the original location of this corner.

Resident witnesses:

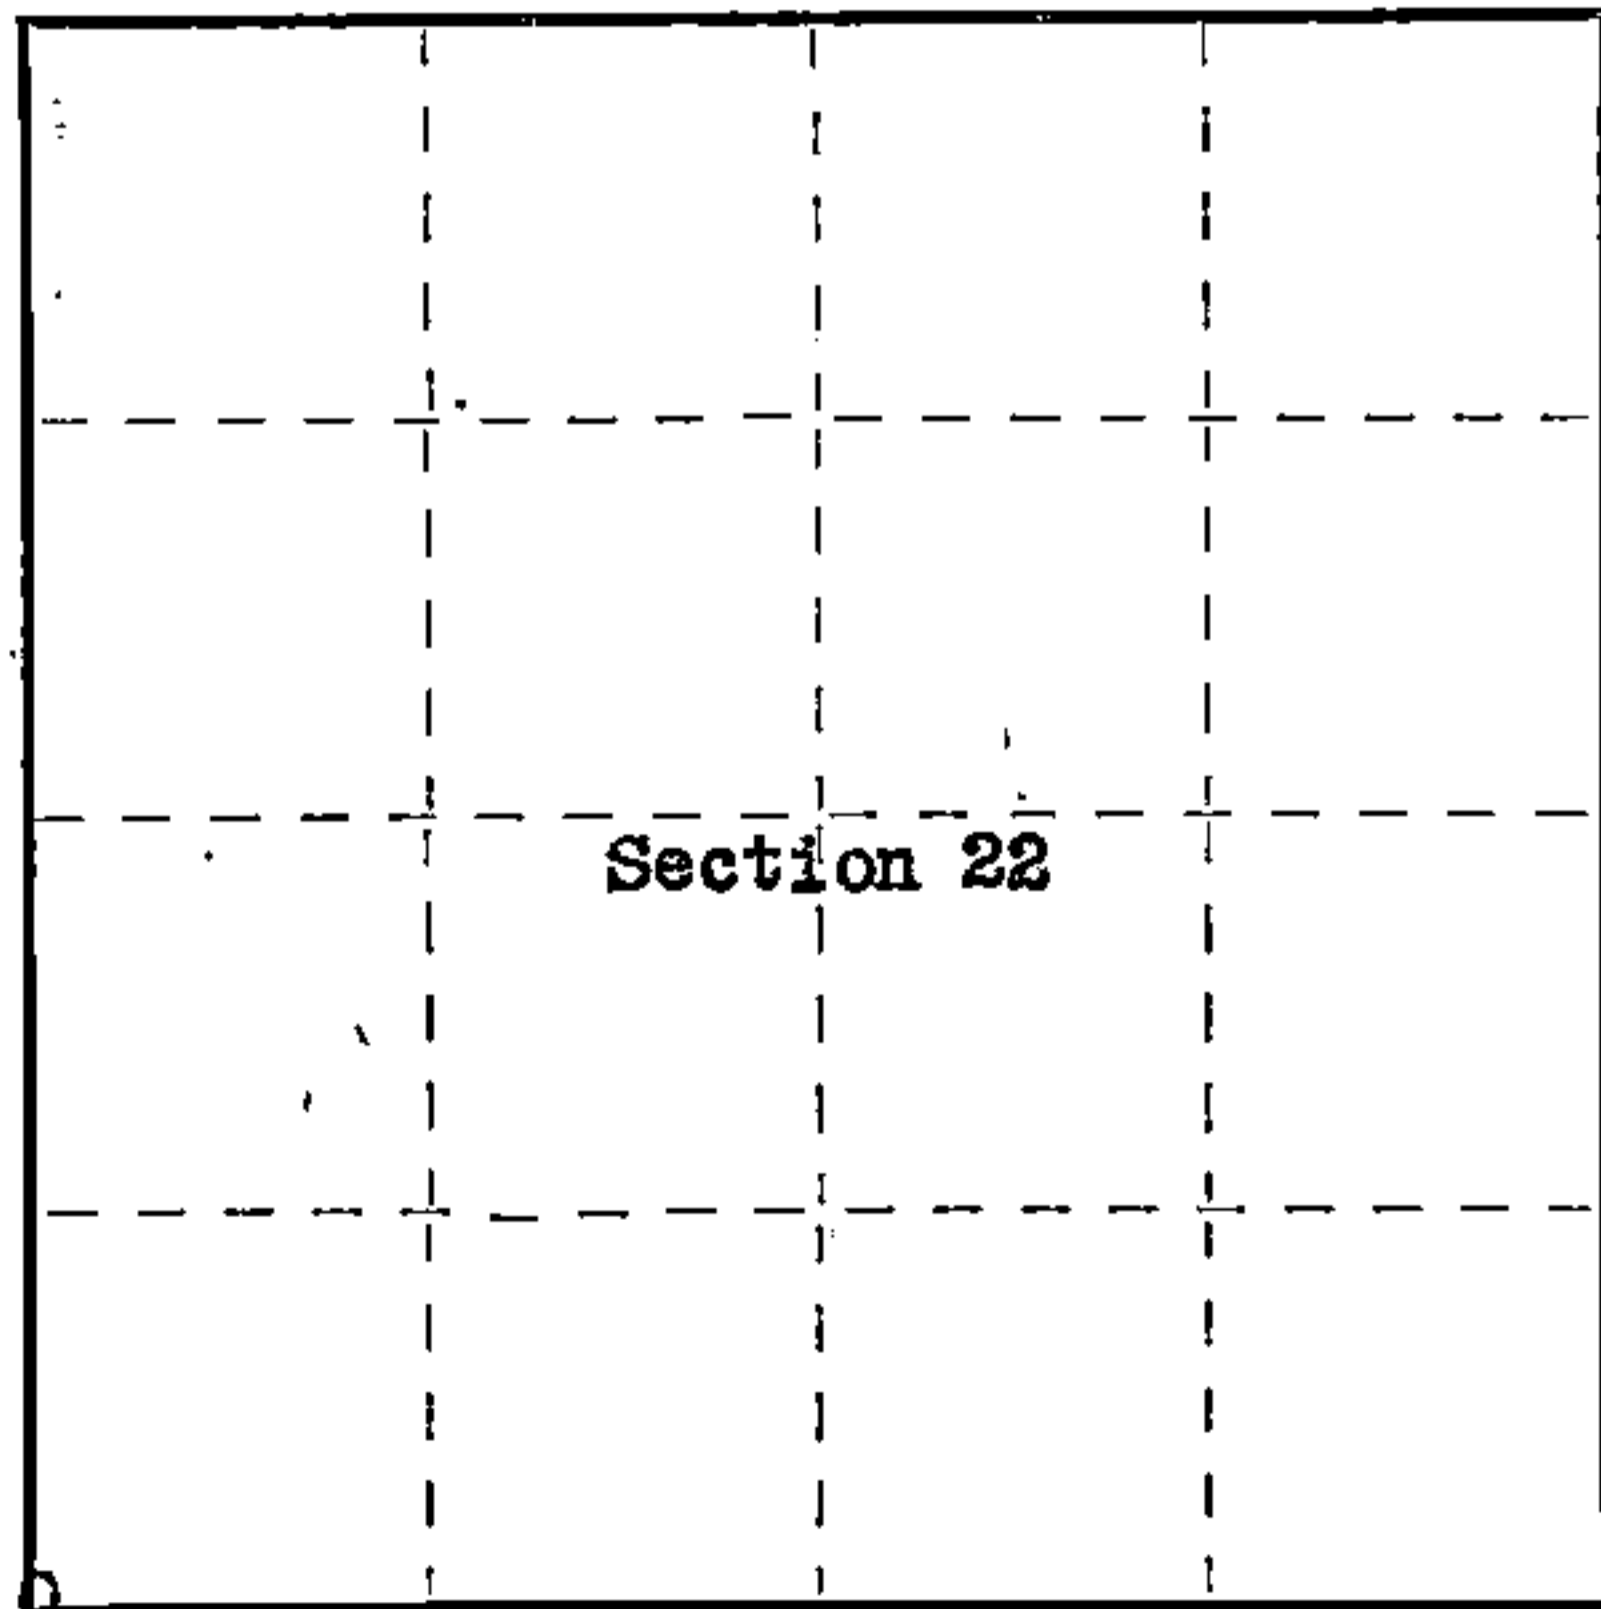

○ = Corner monument restored.

History of original corner establishment:

Original corner established in 1862-1865 by William E. Dougherty, Government Deputy Surveyor.
Original bearing trees: Cedar 10" S76°W 14 lks.
Birch 12" N35°E 37 lks.

Description of corner evidence found:

Original Cedar bearing trees down. Scribe in very good condition.
Set tree in original root hole and reset corner.

Description of monument and accessories I established to perpetuate the original location of this corner.

Set 2"x5' galvanized iron pipe filled with concrete, capped with bronze cap and stamped as follows:

T40N R13E
S21|S22
S23|S27
1959

RLS S-104

Blazed and scribed the following bearing trees: Yellow Birch 12" N70°E 27.2 feet.
Hemlock 20" S50°E 32.2 feet.
Cedar 17" N24°30'W 36.3 feet.

Genisot Engineering Co.

Dated at Rhinelander, Wis., this 30th day of November, 19 59.

Signature Robert E. Badow Title Registered Land Surveyor Registration No. S-104
(County Surveyor, Registered Land Surveyor, or other duly authorized official)

Office of Register of Deeds, County of Forest, I hereby certify that the within instrument was filed in this office for record on the 21st day of March, 19 60 at 9:00 o'clock A.M.

Anna Peterson
(Register of Deeds)

By Deputy

Subscribed and sworn to before me this 4th day of December 1959. Joseph E. Kelly, Notary Public, Oneida Co., Wis. My Commission expires May 1, 1960

4401321000