

U.S. PUBLIC LAND SURVEY MONUMENT RECORD


Index No. R-19

State of Wisconsin }
County of Forest } ss.

I William B. Cochrane, do hereby certify that on the 18th day of September, 1991, I found evidence of the North Quarter corner of Section 26 Township 40, North, Range 13 East, Fourth Principal Meridian, as described hereon; and that from this evidence I established a new monument and accessories as described hereon to perpetuate the original location of this corner.

Resident witnesses:

.....
.....
.....

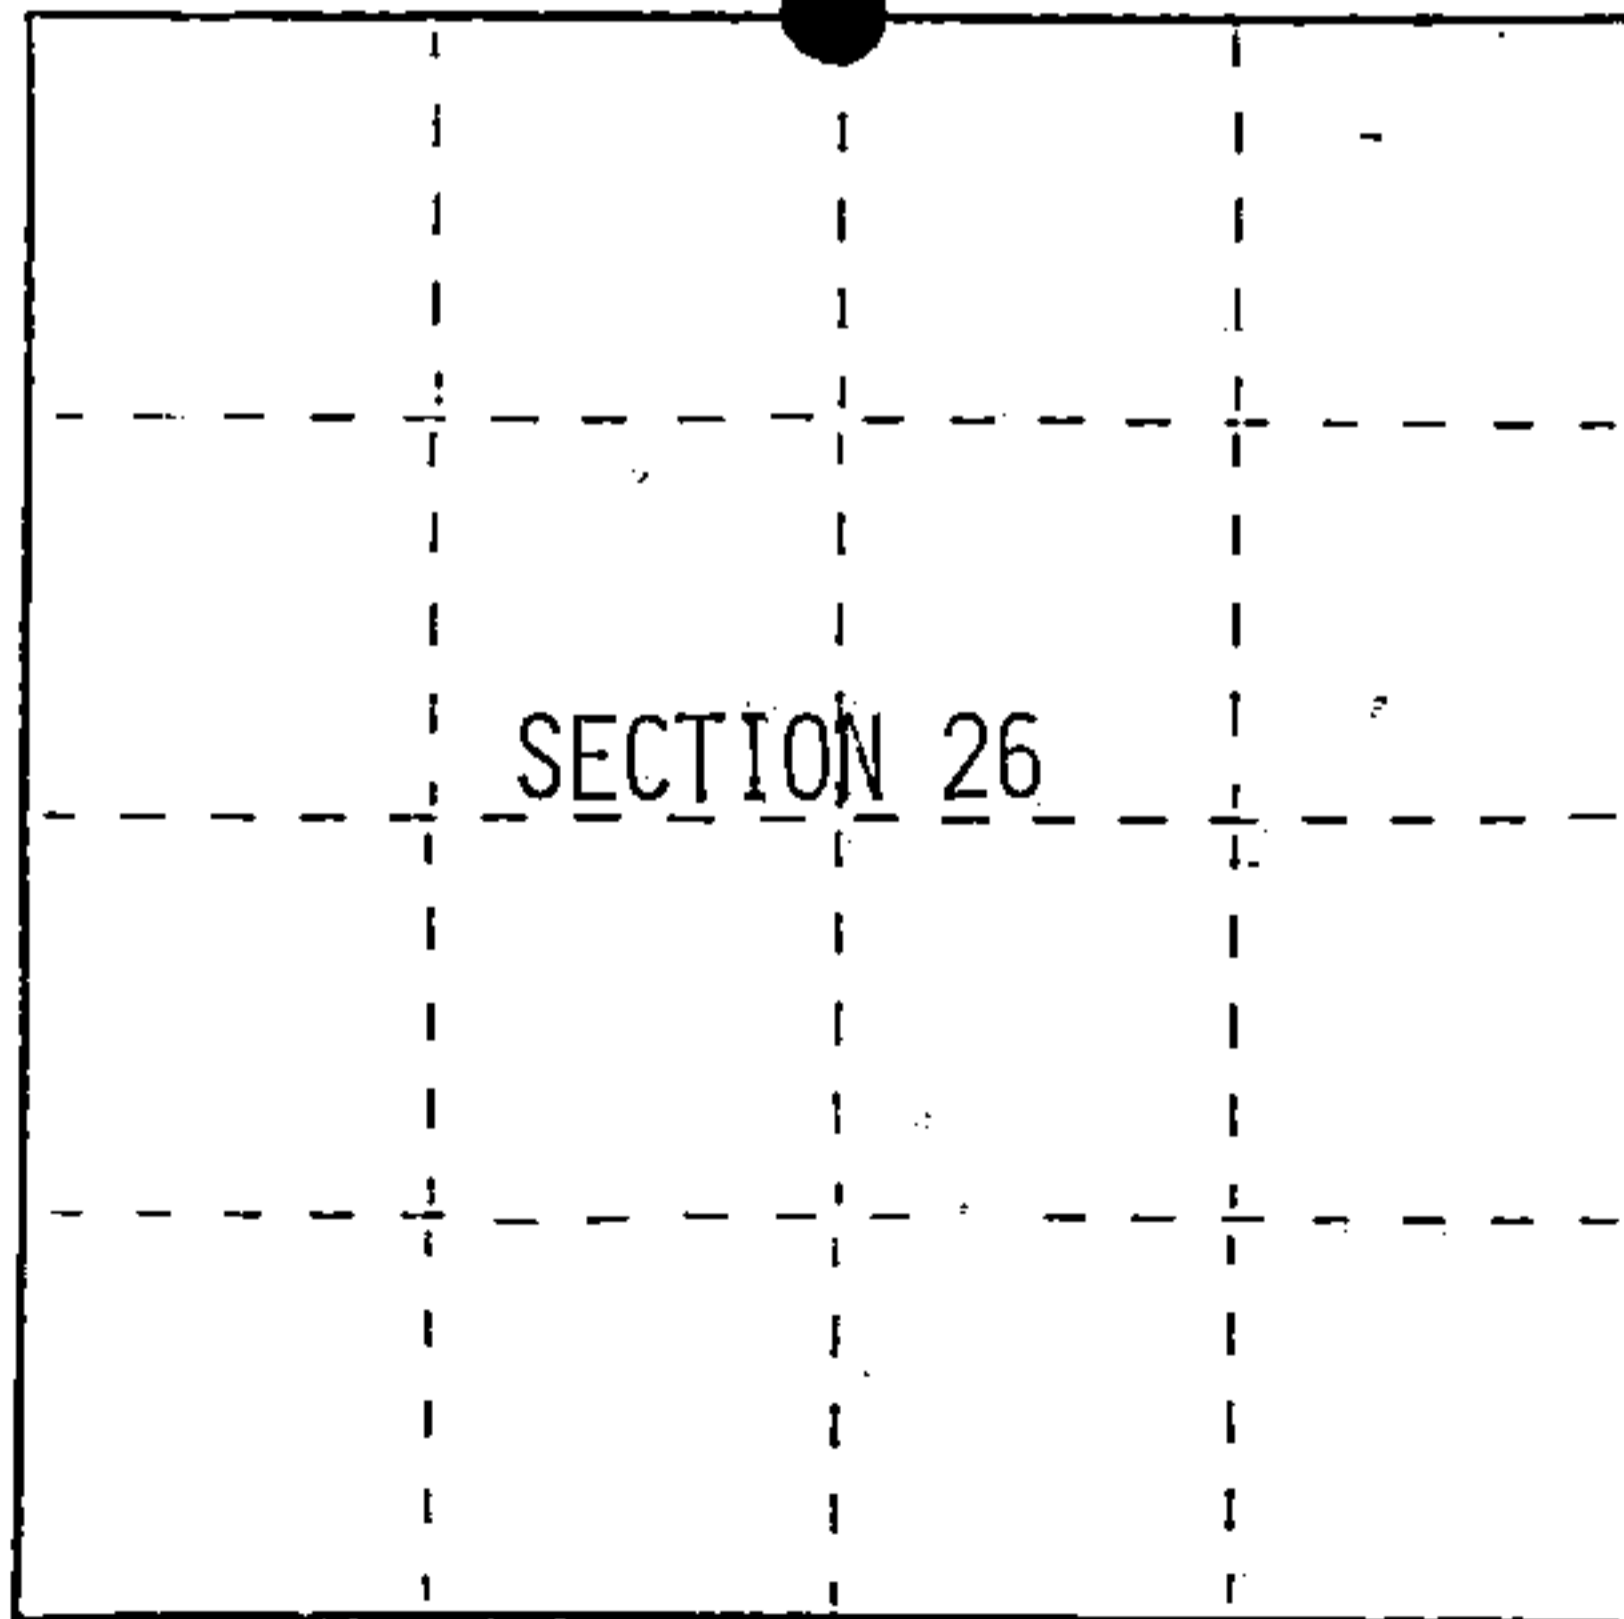

● = Corner monument restored.

History of original corner establishment:
Original Government Survey in 1865 by William E. Daugherty. West corrected between Sections 23 and 26, at 39.82 chains, set Quarter Section Post, from which the following bear;

Alder	3"	S17°E	7 lks.
Cedar	10"	N85°W	220 lks.

Description of corner evidence found:

No corner evidence was recovered.

I re-established the corner position at mid-point and on line between the Northwest and Northeast Section Corners of Section 26.

Description of monument and accessories I established to perpetuate the original location of this corner.
At the corner position, set a 2½ inch diameter aluminum pipe monument, 5 feet long, 4 feet in the ground, with an aluminum cap stamped; T40N R13E, 1/4, S23 S26, 1991, S-1107. From which the following new blazed and scribed bearing trees bear;

Smallest of 3 large boulders in river	S30°E	44.00 feet
North Bank of River	South	30.00 feet
West Bank of River	East	22.00 feet
Set- Steel Sign Post	NW and alongside monument.	

Dated at Hiles, Wis., this 19th day of February, 1992

Signature William B. Cochrane Title Land Surveyor Registration No. S-1107
(County Surveyor, Registered Land Surveyor, or other duly authorized official)

Office of Register of Deeds, County of Forest, I hereby certify that the within instrument was filed in this office for record on the 31st day of August, 1992 at 10:15 o'clock A. M.

Paul Aschenbrenner
(Register of Deeds)

By..... Deputy

FORM NO. 985-A
REGISTRY COMPANY

Stock No. 26273
DOCUMENT NUMBER
145377

44013 230070

