

CERTIFIED LAND CORNER RESTORATION

State of Wisconsin }
County of Forest } ss.

I, Jean F. Resvick, do hereby certify that on the 8 day of September, 1976, I found evidence of the Southeast Section corner of Section 31 Township 40 North Range 13 East, Fourth Principal Meridian, as described hereon; and that from this evidence I established a new monument and accessories as described hereon to perpetuate the original location of this corner:

Description of original monument and accessories and subsequent restorations:



Surveyed in 1858 by Alfred Millard
West between Sections 5 & 32. 80.0 chains set post corner of Sections 5,6,31 & 32
Tamarack, 11", N40°E, 39 lks.
Tamarack, S25°E, 15 lks.
Cedar, 12", S55°W, 16 lks.
Cedar, 9", N56°W, 27 lks.
3.9 chains East stream 10 lks. wide runs South
5.0 chains West leave swamp, bears North & South

Description of corner evidence found:

6x6x30" scribed cedar post
Cedar stump, N60°W, 27 lks, scribed fallen cedar
Tamarack stump, N38°E, 39 lks., scribed fallen log
Tamarack stump, S25°E, 15 lks., B.T. scribe found

Description of monument and accessories I established to perpetuate the location of this corner:

At the corner position determined from the evidence of the original bearing trees, set a 2 inch inside diameter galvanized pipe, 5 feet long, filled with concrete with a brass cap stamped: T40N, R13E, S31, S32, S6, S5, T39N, 1977, S-802
From which the following bear:
Cedar, 10", N30°E, 22.14 feet
Cedar, 8", S20°E, 22.19 feet
Cedar 9", S18°W, 24.98 feet
Set a steel sign post SE, 0.5 feet

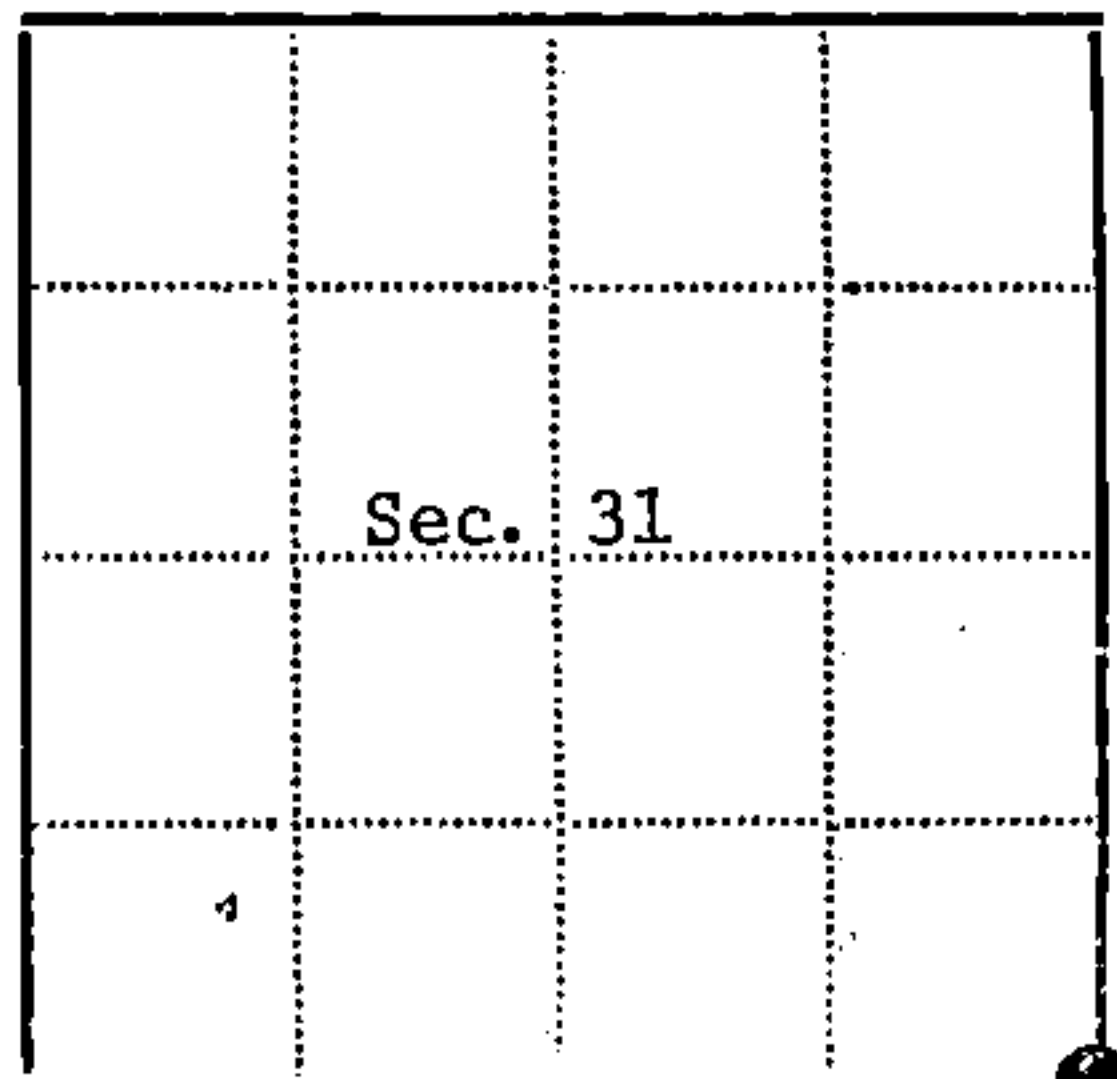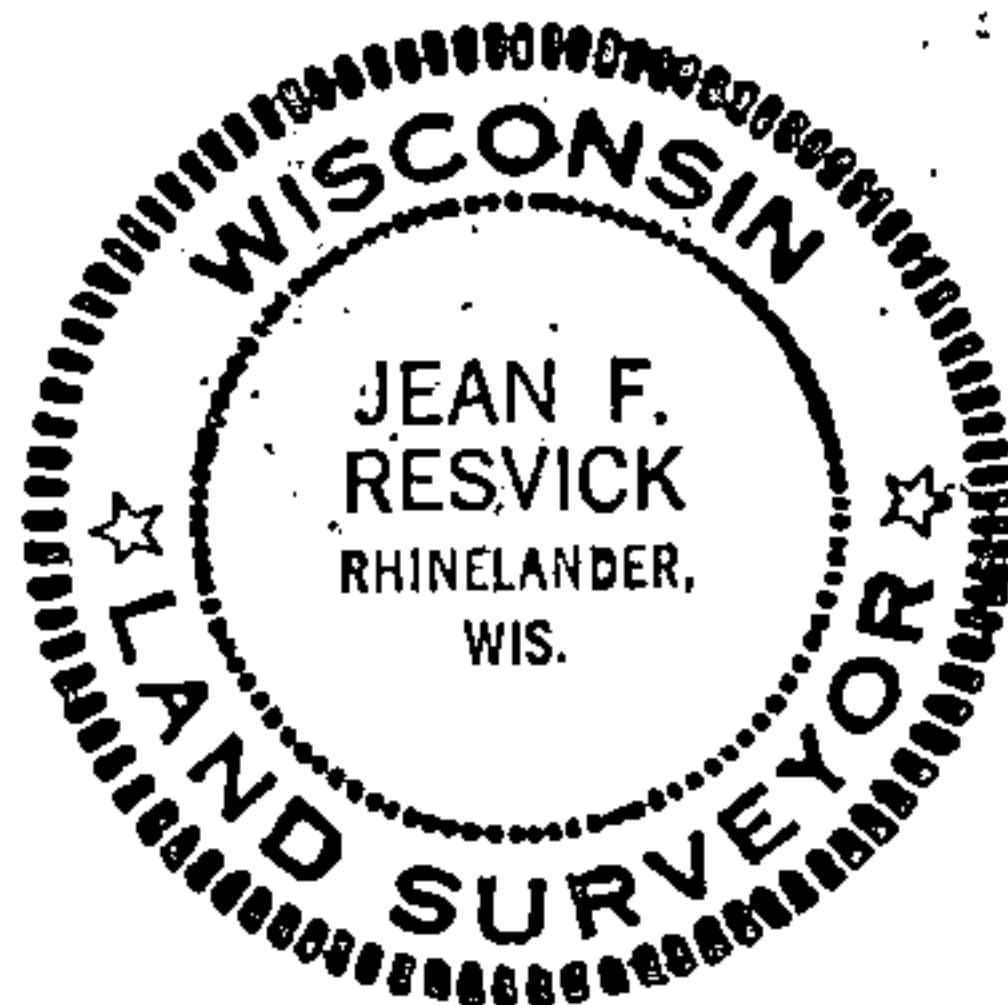

● - Corner monument restored
□ -

Resident witnesses.....

Dated at Rhinelander Wisconsin, this 19 day of July 1977.

Signature *Jean F. Resvick* Title Land Surveyor
(County Surveyor, Registered Land Surveyor, or other duly authorized official)

Surveyors Registration No. S-802 DOCUMENT NUMBER 113311

Office of Register of Deeds County of Forest

I hereby certify that the within instrument was filed in this office for record on the 13th day of February 1978, and was filed in Book No. Page No. of County Records.

Signature *Eugene Stutzman* Title Register of Deeds

Township 40 North Range 13 East Section 31 Index No. Z-5 Page No.

44013310000

25