

CERTIFIED LAND CORNER RESTORATION

State of Wisconsin }
County of Forest } ss.

I, Jean F. Resvick, do hereby certify that on the 26 day of September, 1979, I found evidence of the West Quarter corner of Section 31 Township 40 North, Range 14 East, Fourth Principal Meridian, as described hereon; and that from this evidence I established a new monument and accessories as described hereon to perpetuate the original location of this corner:

Description of original monument and accessories and subsequent restorations:

Surveyed in 1858 by Alfred Millard
40.0 chains north between sections 31 and 36, set post
Tamarack 12, N60E, 25 lks.
Spruce 10, S38W, 30 lks.
10 Chains South leave swamp NE, SW
11 Chains North leave swamp NE, SW

Description of corner evidence found:

2 inch iron pipe along side scribed cedar post
Tamarack stump bears N60E, 25 lks.
10 chains south leave swamp
11 chains north leave swamp
2 post points along side of pipe

Description of monument and accessories I established to perpetuate the location of this corner:

Replace iron pipe with 2 inch diameter aluminum pipe, 5 feet long with aluminum cap stamped: T40N, R13E, R14E, 1/4, S36, S31, 1979, S-802


Blazed and scribed the following new bearing trees:

Black spruce 6, N42E, 28.33 feet
Cedar 10, S37E, 19.14 feet
Cedar 9, S71W, 33.10 feet

Set iron pipe on SW side of monument
Set steel sign post 0.4 feet SW of monument



44013362000

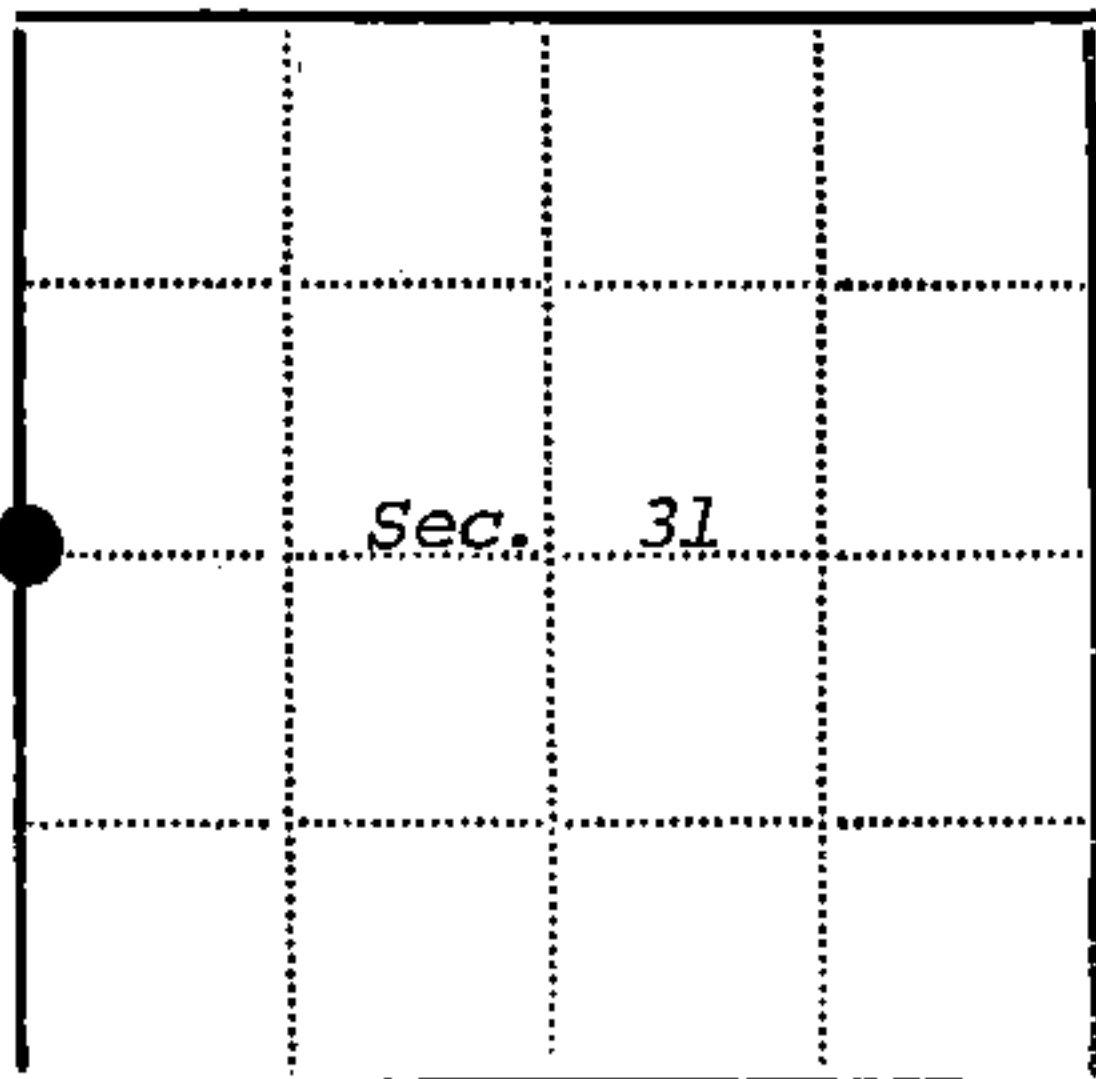

● - Corner monument restored
□ -

Resident witnesses.....

Dated at Rhinelander Wisconsin, this 1 day of October 1979.

Signature Jean F. Resvick Title Land Surveyor
(County Surveyor, Registered Land Surveyor, or other duly authorized official)

Surveyors Registration No. S-802 DOCUMENT NO. 118086

Office of Register of Deeds County of Forest

I hereby certify that the within instrument was filed in this office for record on the 9th day of June 1980, and was filed in Book No. Page No. of County Records.

Signature Sharon Mueller Title Deputy

Township 40 North, Range 14 East, Section 31, Index No. X-1, Page No.

X 1