

CERTIFIED LAND CORNER RESTORATION

State of Wisconsin }  
County of Forest } ss.

I Jean F. Resvick, do hereby certify that on the 2nd day of August, 1976, I found evidence of the Southeast Section corner of Section 12 Township 40 North Range 14 East, Fourth Principal Meridian, as described hereon; and that from this evidence I established a new monument and accessories as described hereon to perpetuate the original location of this corner:

Description of original monument and accessories and subsequent restorations:

Surveyed in 1858 by Artemas Curtis  
Dependent resurvey by Hugh B. Crawford in 1944 thru 1950  
From remains of original evidence set iron post, 3 feet long, 2 ins. diam., 28 ins. in the ground, with brass cap marked T40N, R14E, R15E, S12, S7, S13, S18, 1945  
Poplar 4, N20°45'E, 24 1/2 lks.  
Poplar 4, S80E, 16 lks.  
Poplar 4, S50W, 40 lks.  
Poplar 4, N27W, 29 1/2 lks.

Description of corner evidence found:


Monument in place as described  
Aspen stump N27W, 29 1/2 lks.  
Aspen stump N21E, 24 1/2 lks.  
Other stumps removed by road building and clearing.

Description of monument and accessories I established to perpetuate the location of this corner:

Blazed and scribed the following new bearing trees:

Maple 6, N40E, 15.95 ft.  
Maple 6, S62E, 62.09 ft.  
Maple 7, S76W, 52.31 ft.  
Maple 6, N30W, 26.94 ft.  
Set steel sign post 0.5 ft. north of monument.

44014120000

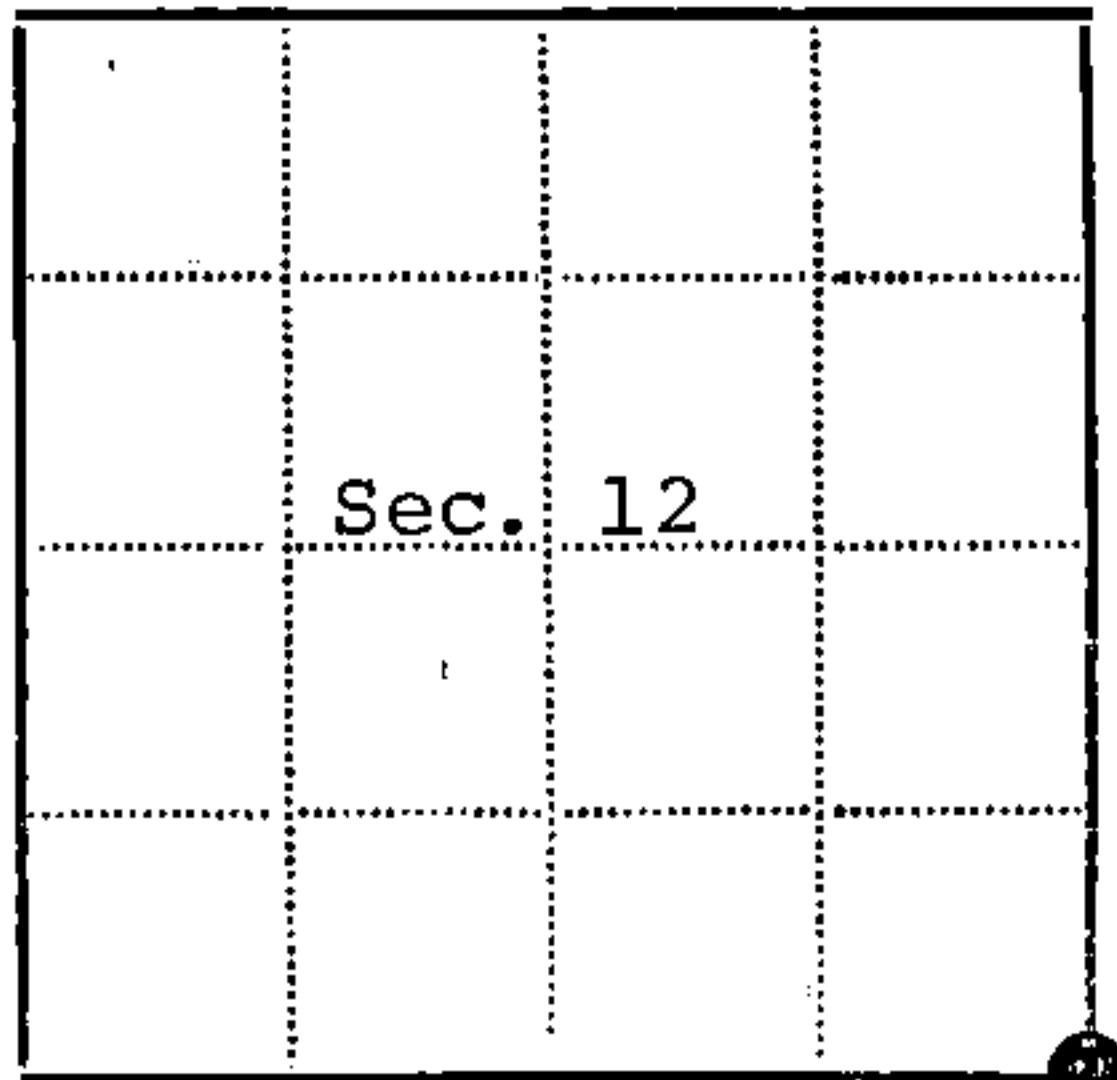

● - Corner monument restored  
□ -

Resident witnesses.....

Dated at Rhinelander Wisconsin, this 5 day of August 1976.

Signature *Jean F. Resvick* Title Land Surveyor  
(County Surveyor, Registered Land Surveyor, or other duly authorized official)

Surveyors Registration No. S-802 DOCUMENT NUMBER 110927

Office of Register of Deeds County of Forest

I hereby certify that the within instrument was filed in this office for record on the 31st day of January 1977, and was filed in Book No. Page No. of County Records.

Signature *Eugene Stutzman* Title Register of Deeds

Township 40 North, Range 14 East, Section 12, Index No. J-25, Page No.

7  
25