

U.S. PUBLIC LAND SURVEY MONUMENT RECORD


Index No. L-25

State of Wisconsin }  
 County of Forest } ss.

I, William B. Cochran, do hereby certify that on the 25th day of August, 1987, I found evidence of the East Quarter corner of Section 13 Township 40 North, Range 14 East, Fourth Principal Meridian, as described hereon; and that from this evidence I established a new monument and accessories as described hereon to perpetuate the original location of this corner.

Resident witnesses:

.....  
 .....  
 .....

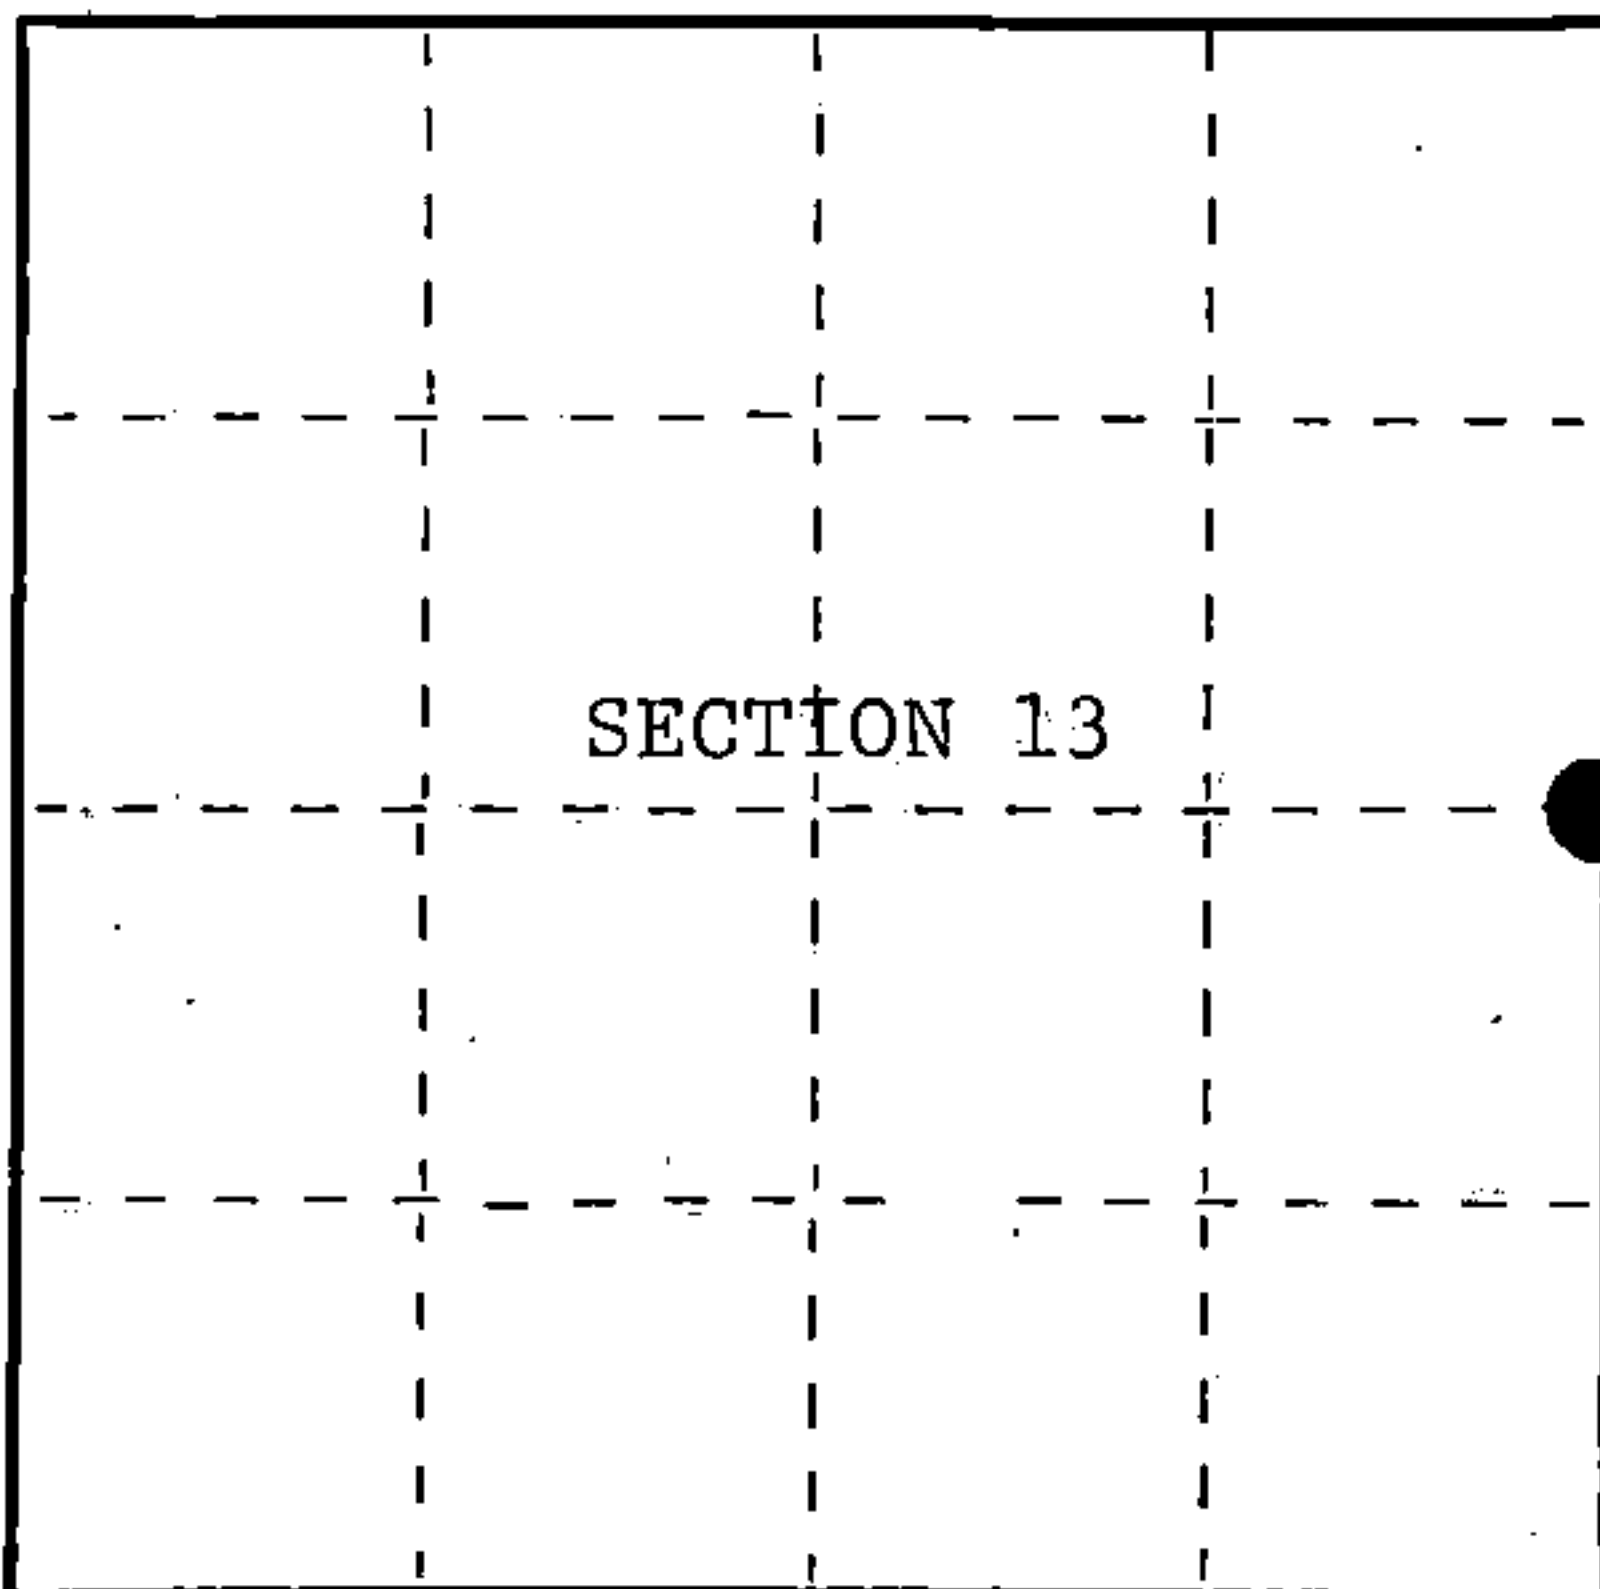

○ = Corner monument restored.

History of original corner establishment:

Original Government Survey in 1858 by Artemas Curtis.

Dependent Resurvey in 1945 by Hugh B. Crawford. From the remains of original bearing trees, set a 4 inch diameter concrete monument, 3 feet long, 28 inches in the ground, with an iron post in center, and a brass cap mkd; 1/4, S13, S18, 1945. From which the following bear;

Elm	4"	N43°30'W	22.00 lks.
Elm	6"	S51°30'E	21.50 lks.

Description of corner evidence found:

Found monument as described and in place, from which the following bears;

Elm(Dead)	10"	S51°30E	14.19 feet
-----------	-----	---------	------------

The NW bearing tree was removed from road construction.

Description of monument and accessories I established to perpetuate the original location of this corner.

Blazed and scribed the following new bearing trees;

Maple	6"	N29°E	10.95 feet
Maple	5"	S27°E	11.74 feet
Steel Sign Post		NE	0.75 feet

Dated at Hiles, Wis., this 7th day of January, 1988

Signature William B. Cochran Title Land Surveyor Registration No. S-1107  
 (County Surveyor, Registered Land Surveyor, or other duly authorized official)

Office of Register of Deeds, County of Forest, I hereby certify that the within instrument was filed in this office for record on the 18th day of March, 1988 at 12:50 o'clock P. M.

Paul Aschenbrenner  
 (Register of Deeds)

By \_\_\_\_\_ Deputy

FORM NO. 985-A

H.C. Miller Company

Stock No. 26273

DOCUMENT NUMBER 134839

44014132000

