

CERTIFIED LAND CORNER RESTORATION

State of Wisconsin }  
County of Forest } ss.

I, Jean F. Resvick, do hereby certify that on the 2nd day of October, 1974, I found evidence of the Witness Point corner of Section 25 and 26 Township 40 North, Range 14 East, Fourth Principal Meridian, as described hereon; and that from this evidence I established a new monument and accessories as described hereon to perpetuate the original location of this corner:

Description of original monument and accessories and subsequent restorations:


Dependent Resurvey of 1945 by H. B. Crawford  
N0°31'W between Section 25 and 26 and over lake to north shore of Big Wapoose Lake. Set iron post, 3 feet long, 2 inches diameter, 28 inches in ground for a witness point with brass cap marked: WP, S26, S25, 1945.  
Cedar 4, bears N44°15'E, 48.5 lks  
Tamarack 4, bears N3°45'W, 38 lks

Description of corner evidence found:


Monument found as described above.  
Cedar, stump scribed, N44E, 48.5 lks  
Tamarack, stump scribed, N4W, 38 lks

Description of monument and accessories I established to perpetuate the location of this corner:

Blazed and scribed new bearing tree  
Spruce 5, bears N23E, 7.70 feet  
Set steel sign post on west side of monument.

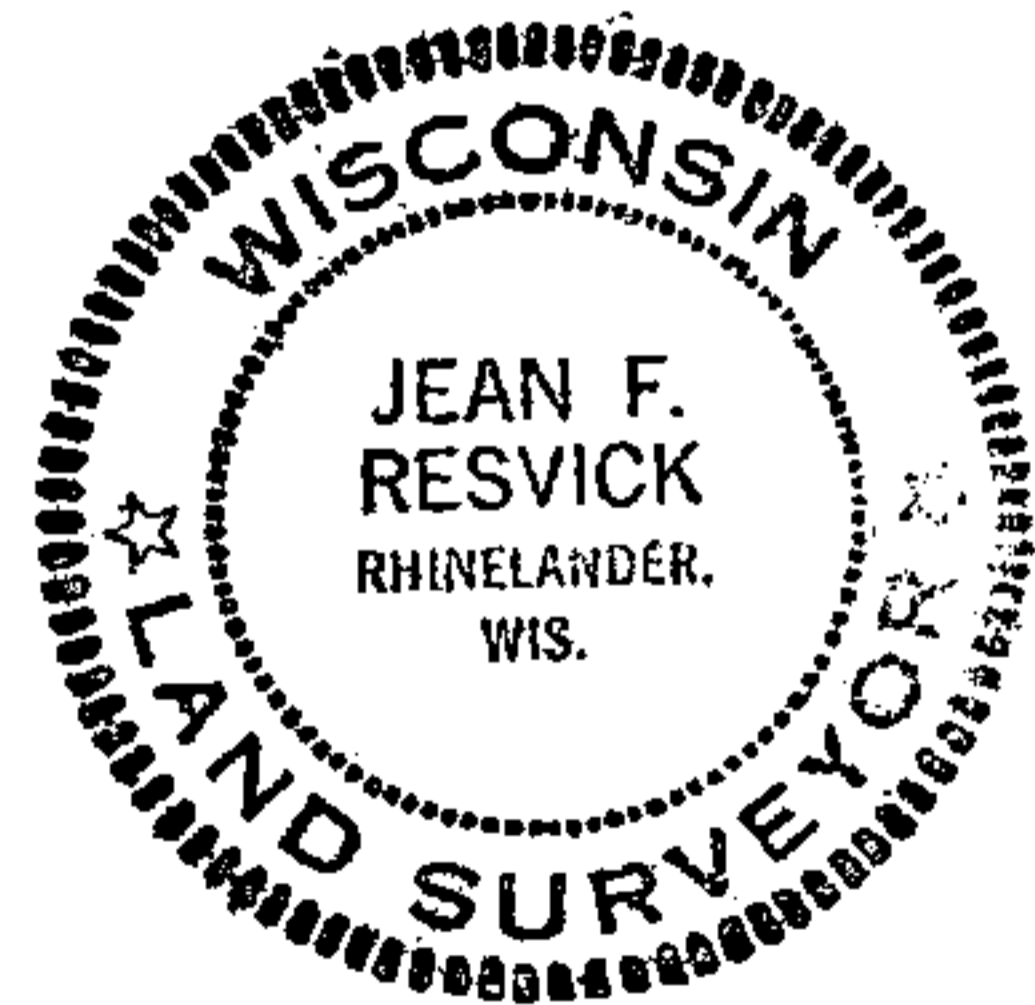

44014 261500

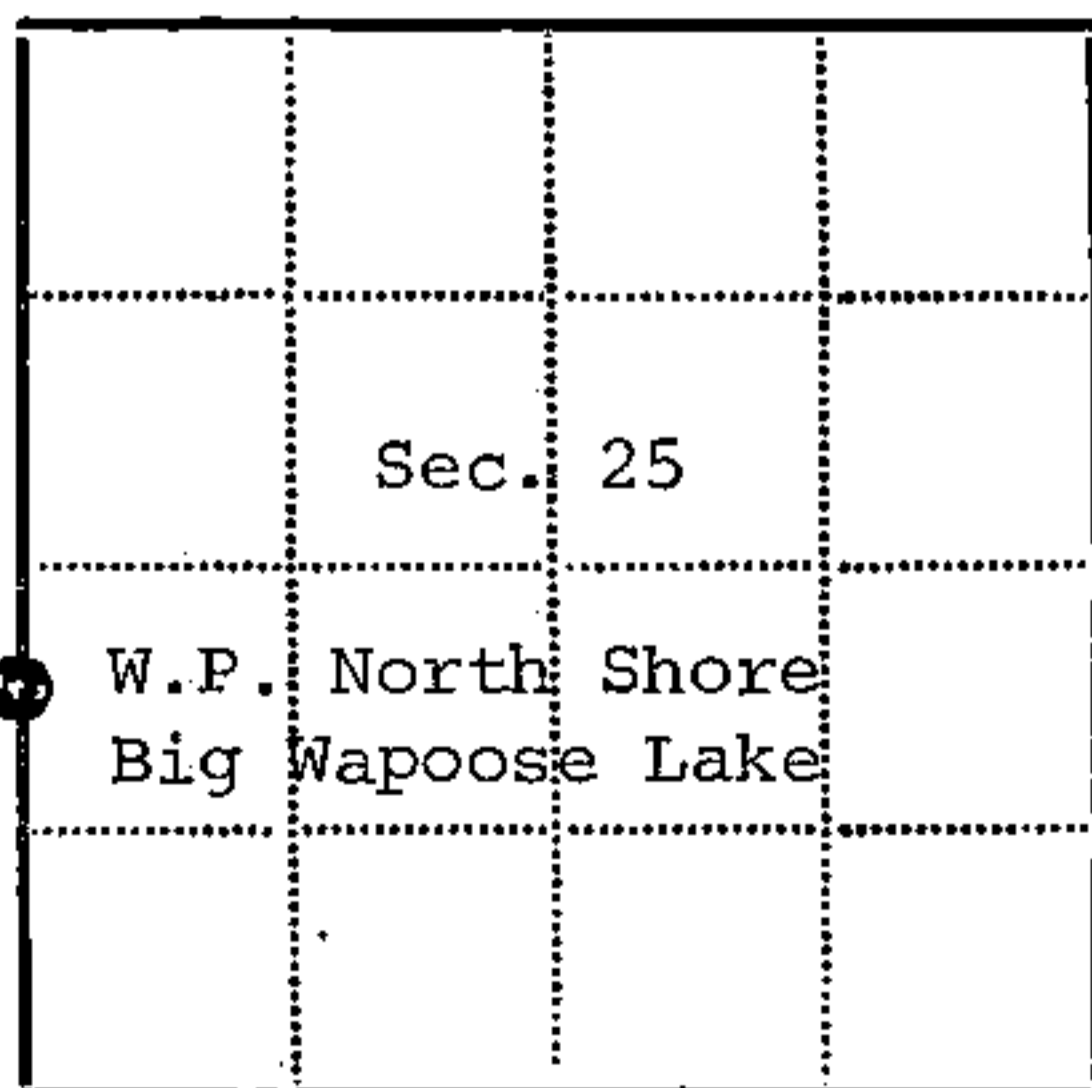

● = Corner monument restored  
□ =

Resident witnesses.....

Dated at Rhinelander Wisconsin, this 20 day of March 19 75.

Signature Jean F. Resvick Title Land Surveyor  
(County Surveyor, Registered Land Surveyor, or other duly authorized official)

Surveyors Registration No. S-802 Document Number 106887

Office of Register of Deeds County of Forest

I hereby certify that the within instrument was filed in this office for record on the 31st day of March 19 75, and was filed in Book No. Corner Restorations Page No. T, U-21 of County Records.

Signature Eugene Staszynski Title Register of Deeds

Township 40 North, Range 14 East, Section 25, Index No. T, U-21, Page No.

T U 21