

U.S. PUBLIC LAND SURVEY MONUMENT RECORD

Index No. J-16, 17

State of Wisconsin }
County of FOREST } ss.

I John Schulke, do hereby certify that on the 30th day of July, 1985, I found evidence of the Closing corner corner of 10 and 15 Township 41, North, Range 13 East, Fourth Principal Meridian, as described hereon; and that from this evidence I established a new monument and accessories as described hereon to perpetuate the original location of this corner.

Resident witnesses:

History of original corner establishment:

Original corner was established by Wm. E. Daugherty, Deputy Surveyor in June 1865 in the survey of the subdivision of T41N, R13 E.

Original Bearing Trees: Birch 7" N83°W 10 lks.
Spruce 7" S11°E 14 lks.

Description of corner evidence found:

Found 2" Dia. iron pipe set by Guy Veal in 1942 with a brass cap stamped to identify the corner. Steel sign post located 1.5 feet SW.


Recovered 1942 Bearing Trees:

Sug. Maple 16" S7°30'W 34.65 feet
Sug. Maple 19" S85°W 56.34 feet

Description of monument and accessories I established to perpetuate the original location of this corner.

Blazed and scribed the following new bearing trees:

Sug. Maple 9" S24°E 55.25 feet
Sug. Maple 13" N04°W 24.10 feet

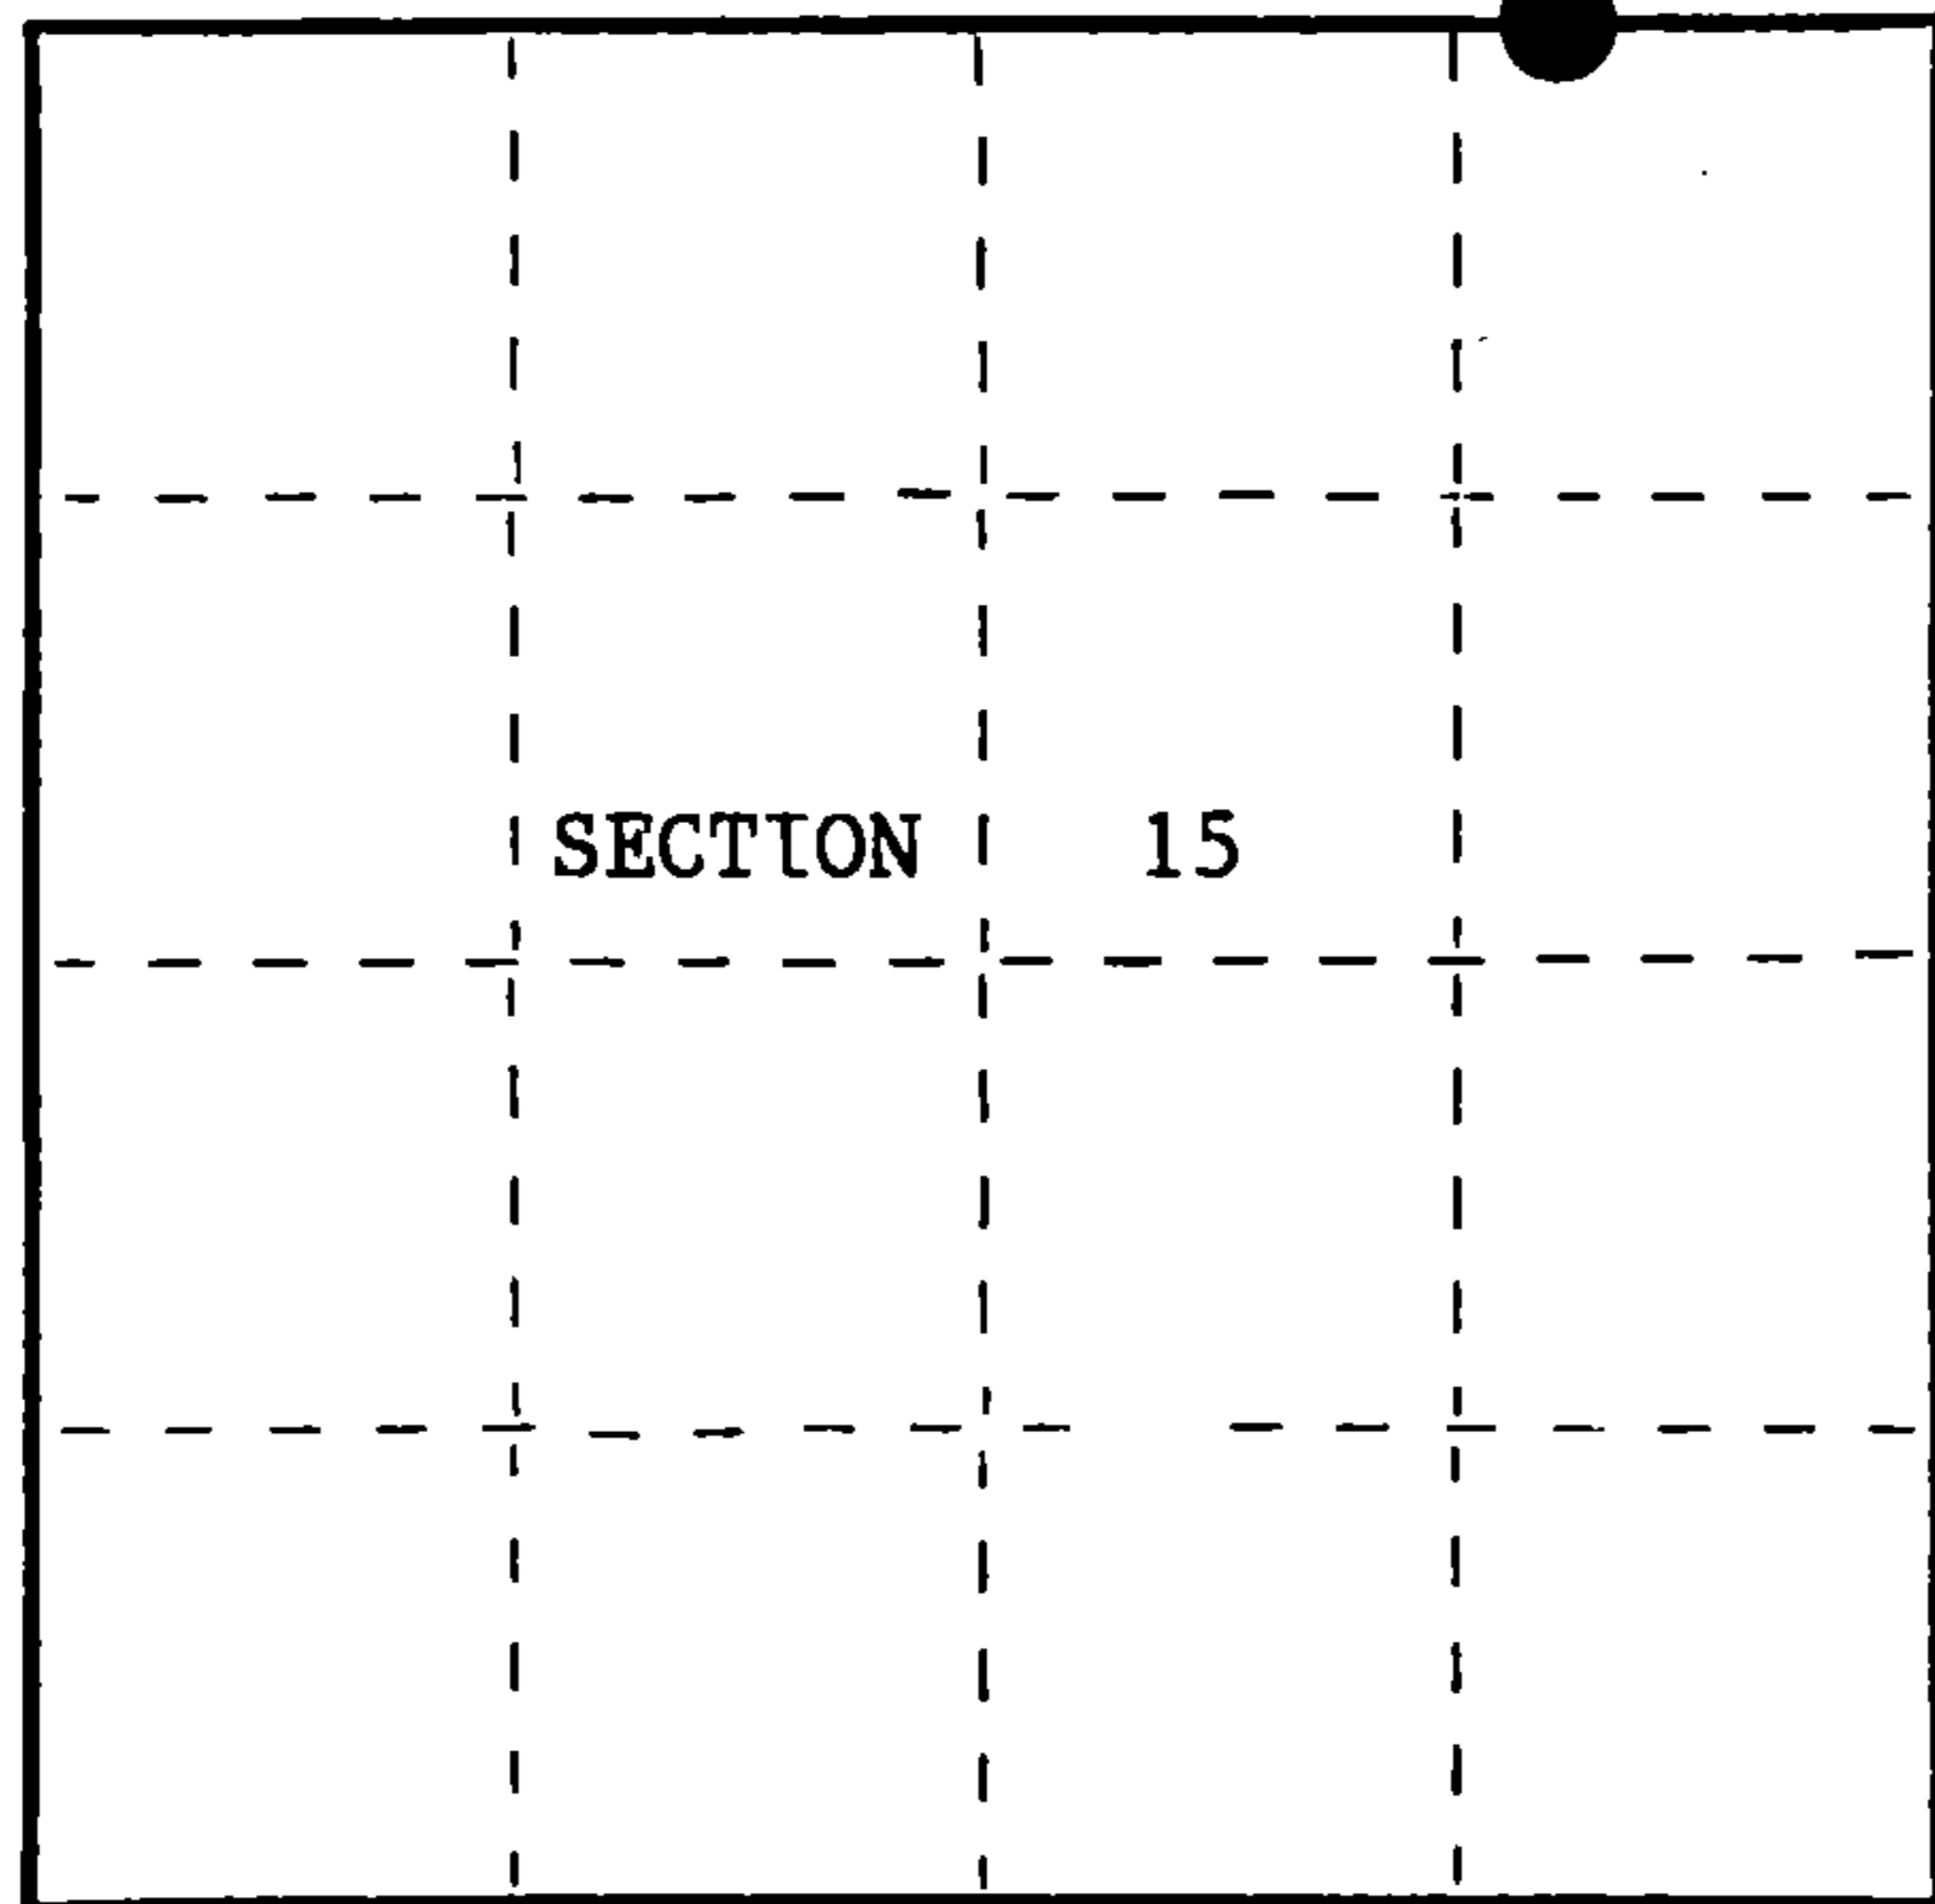

○ = Corner monument restored.

Dated at Crandon, Wis., this 10th day of October, 1985.


Signature John C. Schulke Title R.L.S. Registration No. S-1665
(County Surveyor, Registered Land Surveyor, or other duly authorized official)

Office of Register of Deeds, County of Forest, I hereby certify that the within instrument was filed in this office for record on the 21st day of November, 1985 at 1:10 o'clock P.M.

Paul Aschenbrenner
(Register of Deeds)

By Deputy

FORM NO. 985-A

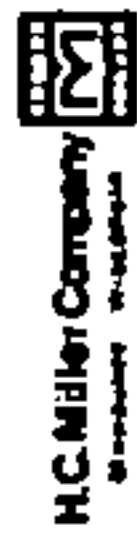

Stock No. 26273
DOCUMENT NUMBER 129277

800001311414



(e) Describe any material discrepancy between the location of the corner as restored or reestablished and the location of that corner as previously restored or reestablished by distance and direction. Show the discrepancy on the plan view drawing under (d), above. Show the distances between the corner as previously restored or reestablished and (1) the corner as restored or reestablished, and (2) to at least 2 of the witness monuments shown on the drawing in (d), above.

NONE

(f) Was the corner restored through acceptance of (1) an obliterated evidence location, or, (2) a found perpetuated location?

(g&h) Was the corner reestablished through lost corner proportionate methods? If so, show the method, including the directions and distances to other public land survey corners used as evidence or used for proportioning in determining the corner location?

SECTION 10

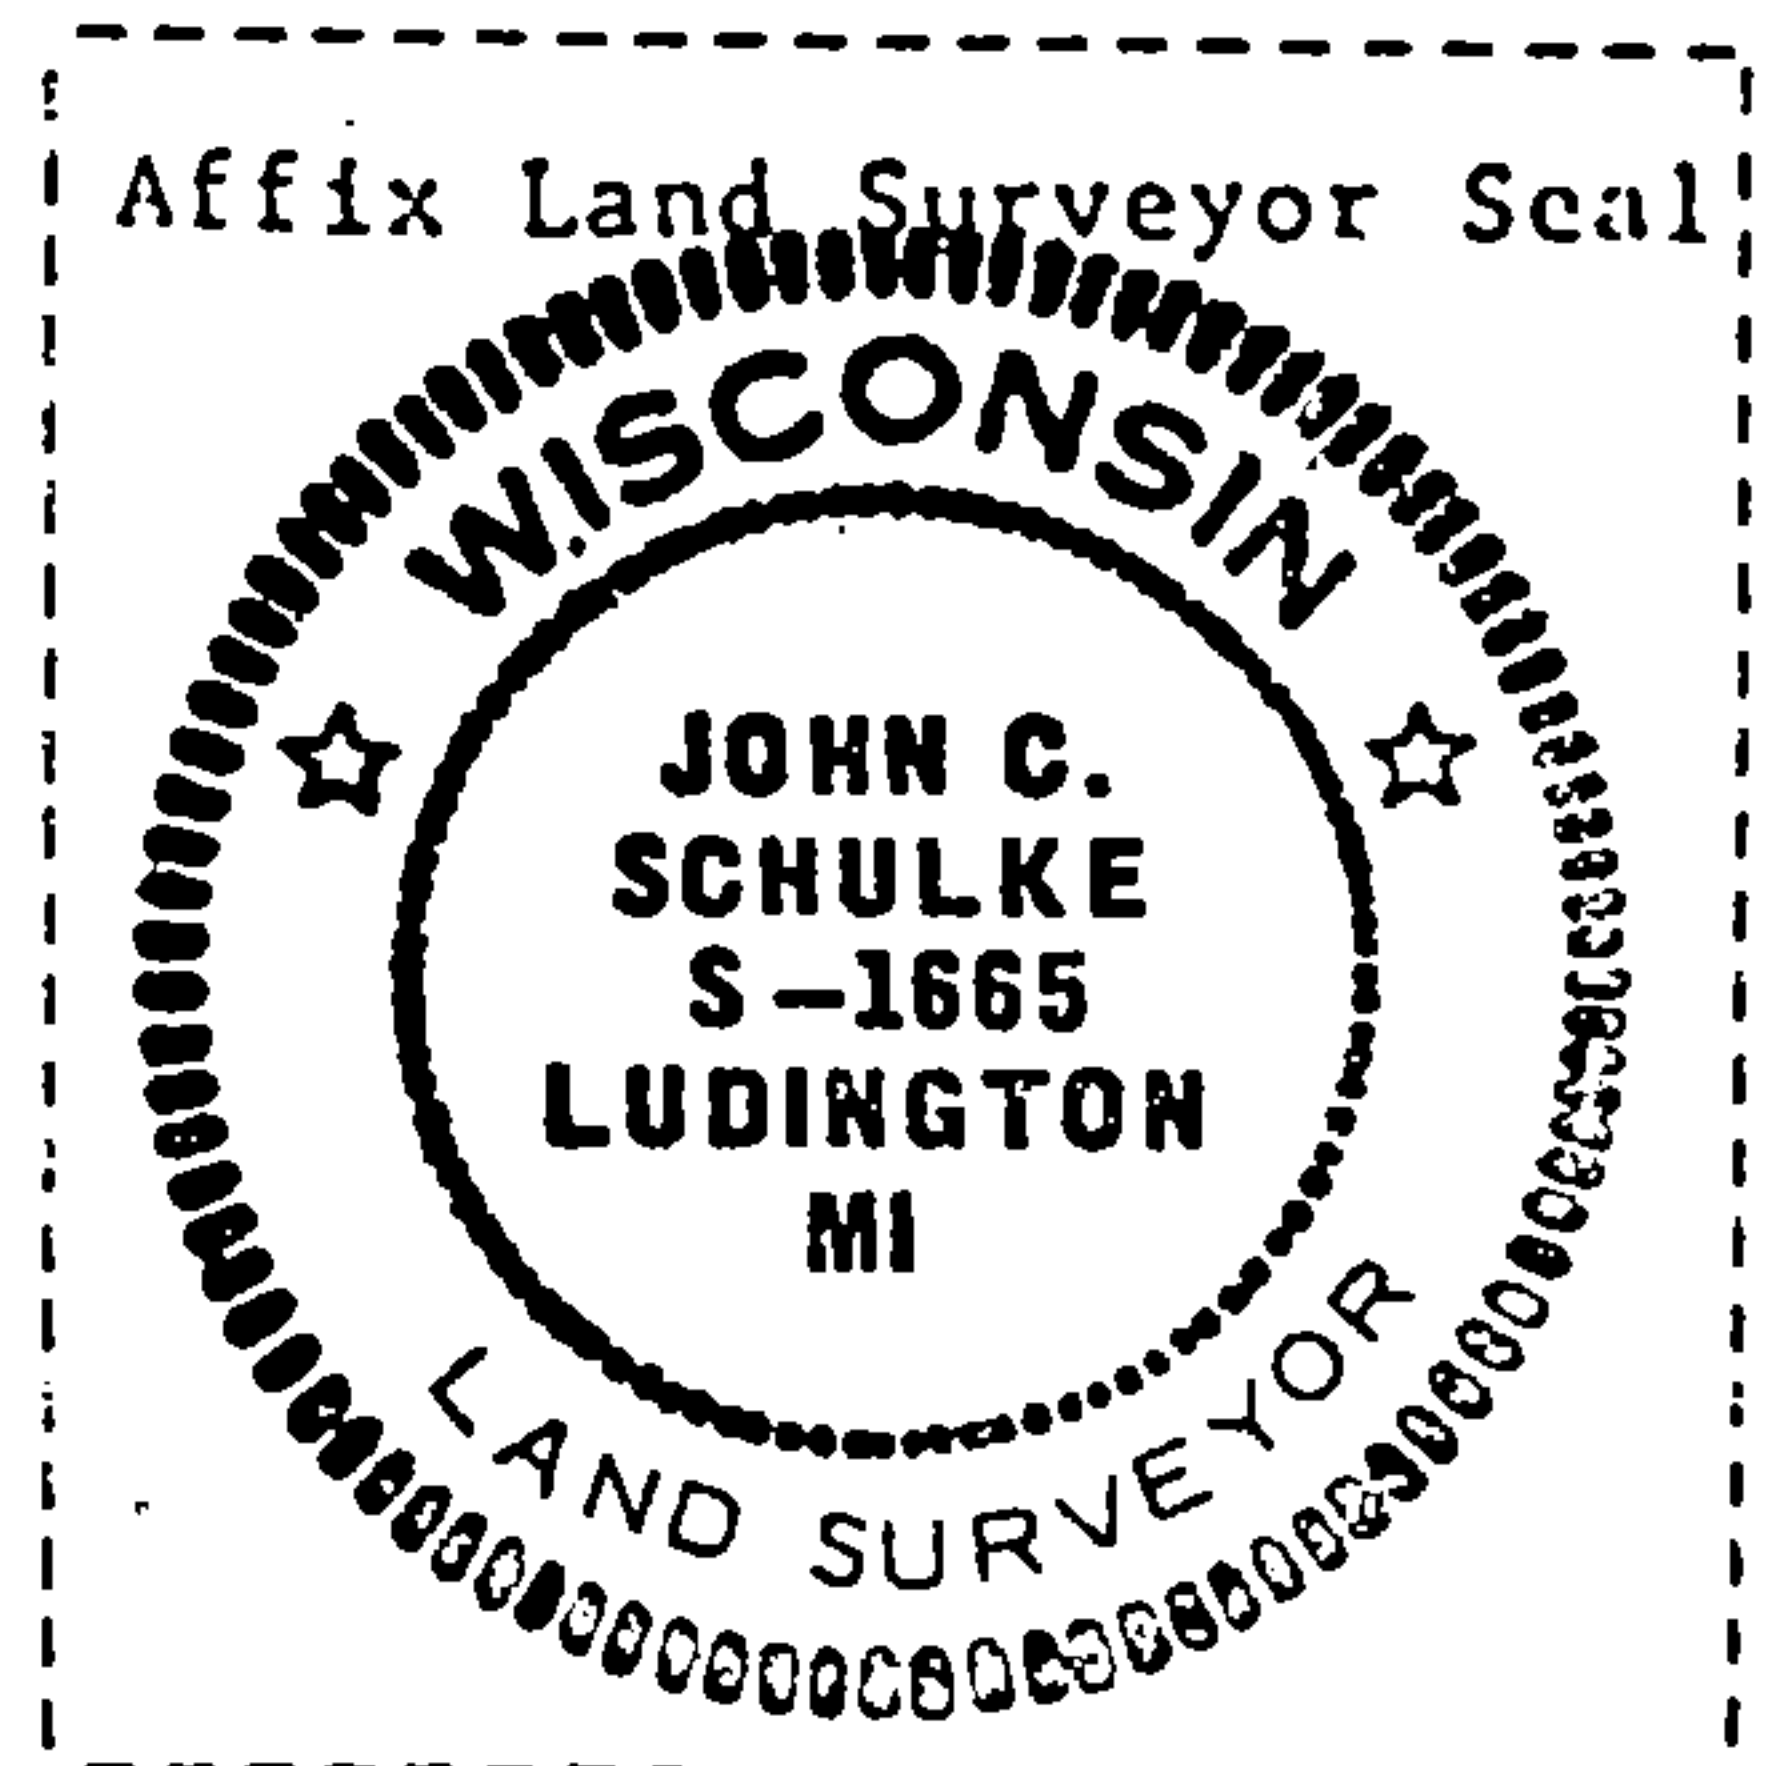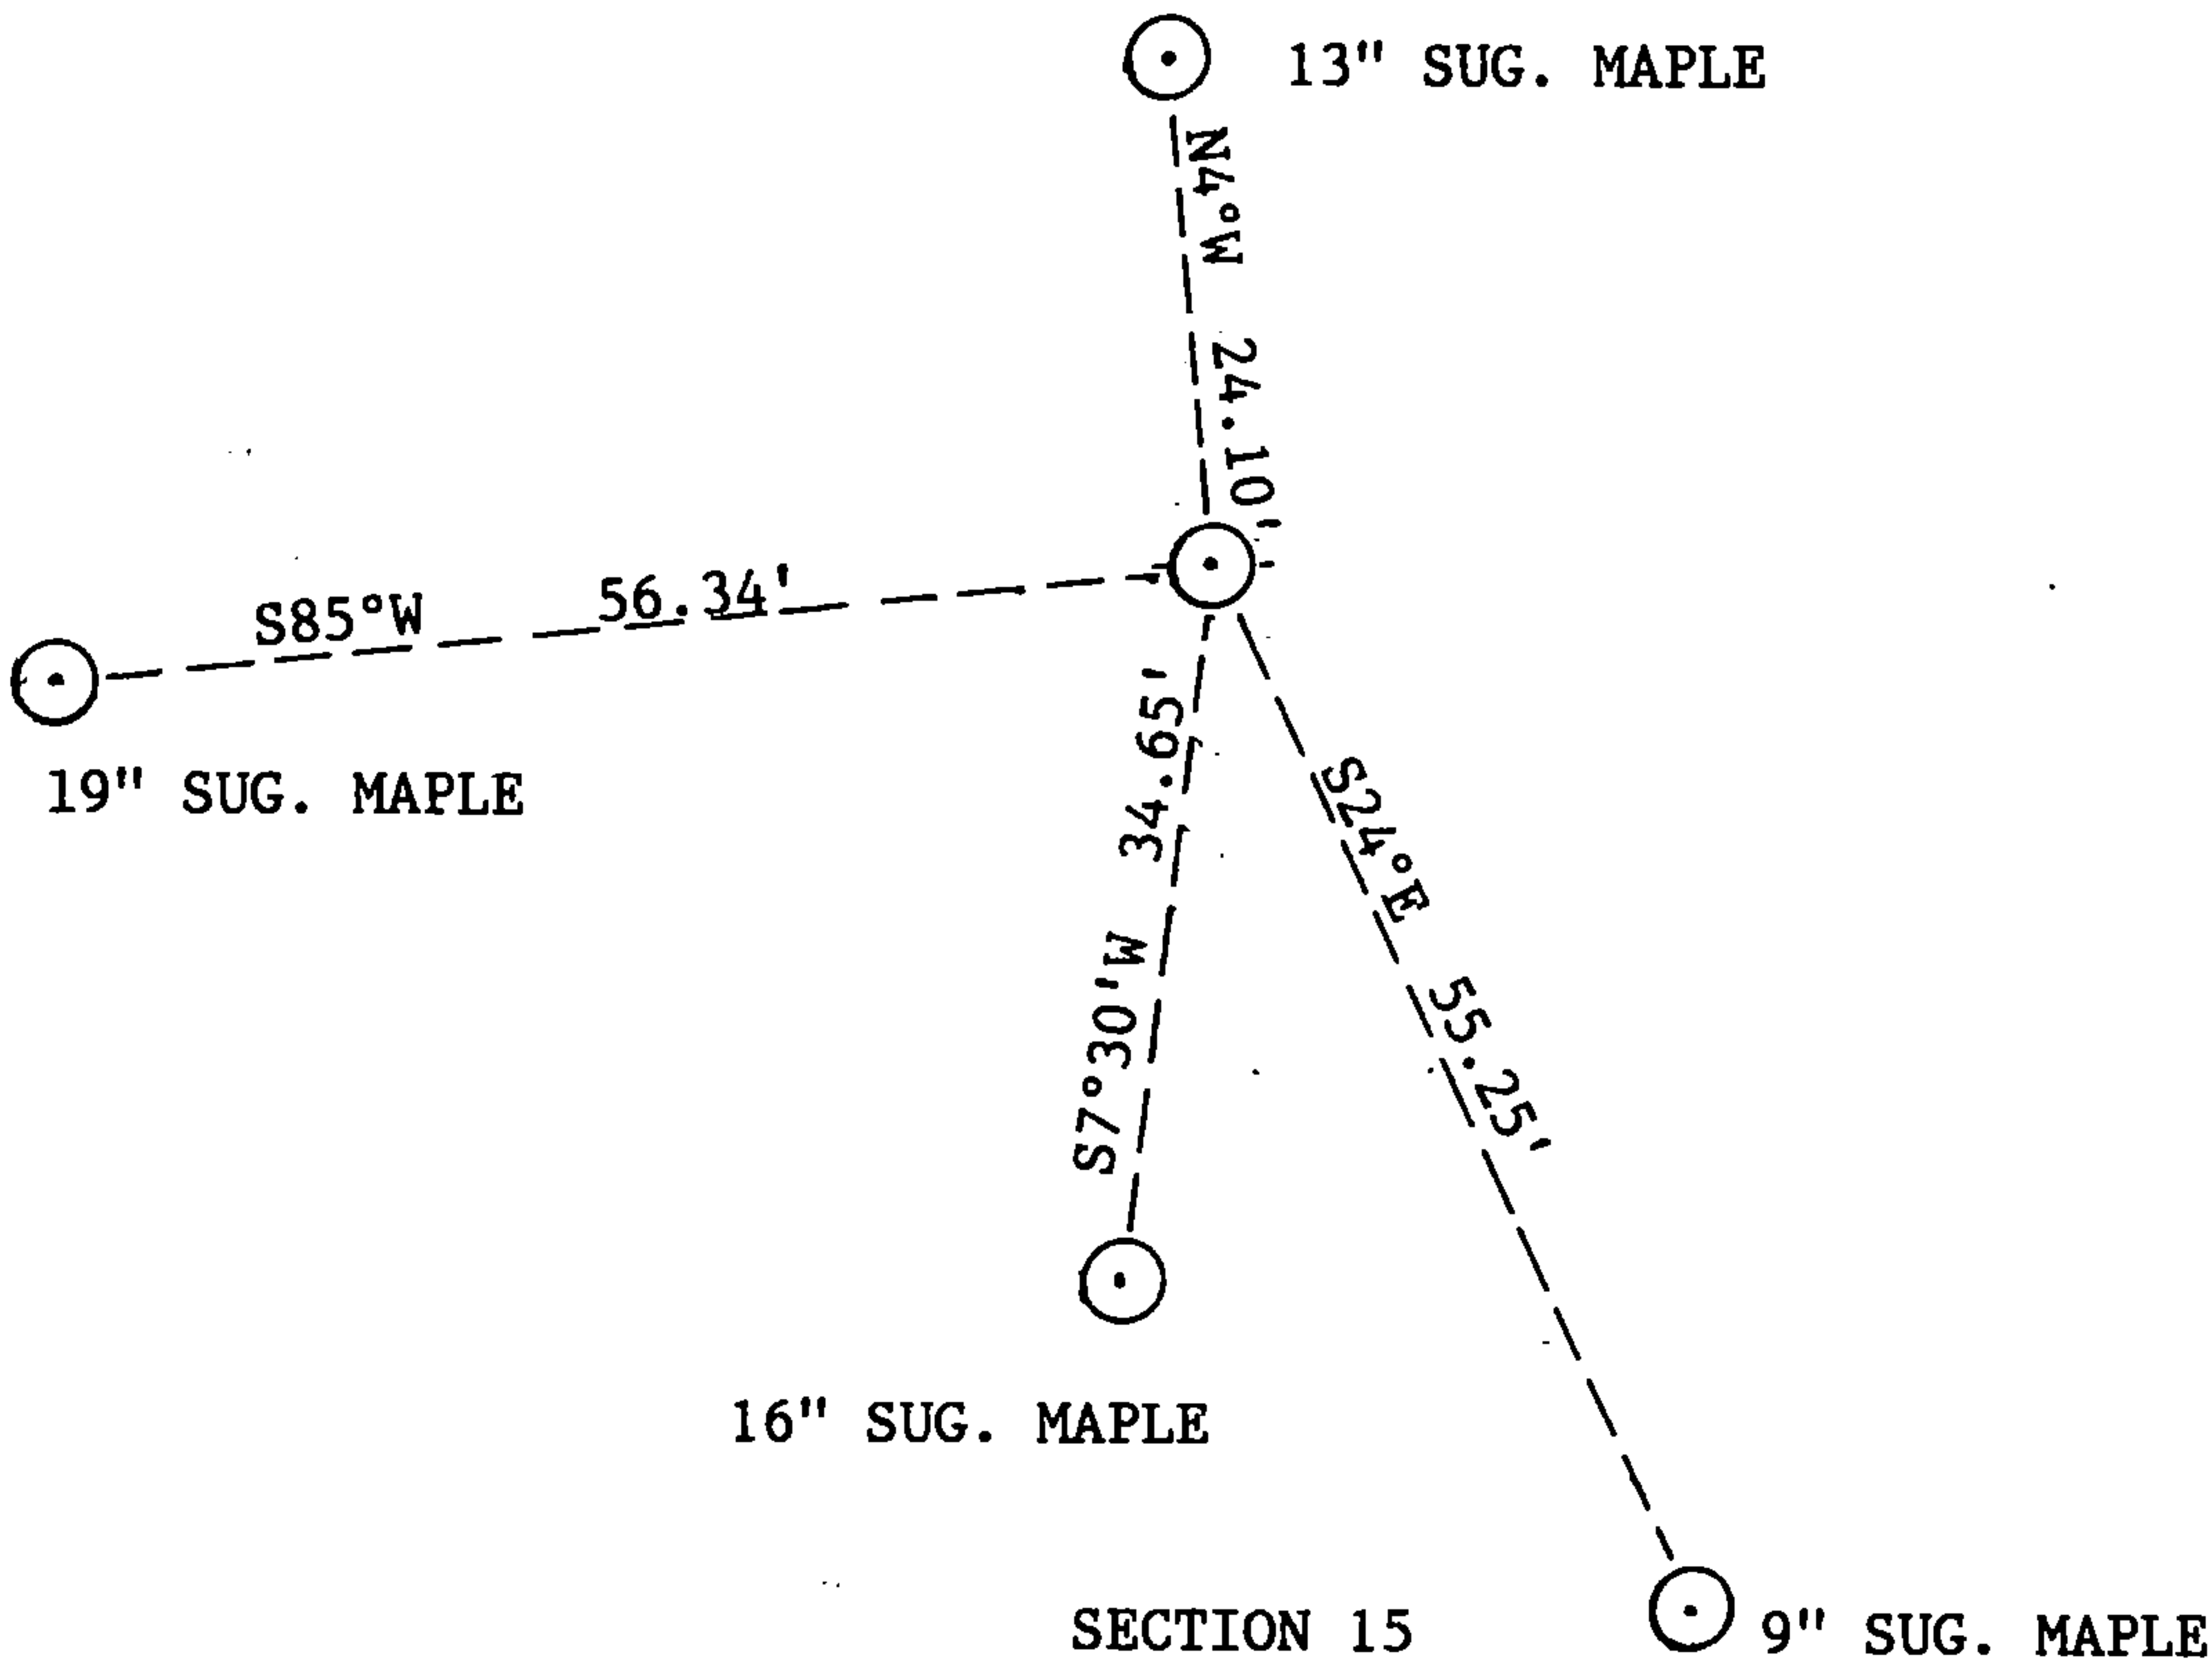

(i) I, John C. Schulke, R.L.S.
 (type or print name) certify that the corner location shown on this record was determined by me or under my direction and control and that this U.S. Public Land Survey Monument Record is correct and complete to the best of my knowledge and belief.

John C. Schulke
 Signature

October 10, 1985
 Date