



U.S. PUBLIC LAND SURVEY MONUMENT RECORD

(As Required by W Adm. Code)

History of original corner establishment and subsequent restorations and descriptions of any record, monument, occupational, testimonial or other evidence considered:

1865 — William Daugherty set original corner post. Orig. B.T.'s: Spruce 15", S 38° W, 11 links Cedar 12", S 23" E, 20 links

1942 — BLM Dependent resurvey by Guy R. Veal, set a witness corner to the meander corner. W. C. marked with a 6" dia. concrete monument with stamped brass cap which reads:

2001 — I found the above described W.C., M.C. Monument and made the following B.T.'s.

W. C.

W. C.

S14 S13

OTHER TAIN R13E

Restored through acceptance of an obliterated evidence location.

Corner was:

X Restored through acceptance of a found perpetuated location.

Considered a lost corner and reestablished through lost corner proportionate methods (include a plan view drawing showing distances and directions to other Public Land Survey Corners used for proportioning and determining the corner location).


Restored or reestablished in a location that differs from a previous restoration or reestablishment (include a plan view drawing and indicate what was set and/or found).

Describe the monument and accessories used to perpetuate the location of this corner (include a plan view drawing and indicate what was set and/or found).

±12'-2 80. E W.C. 18.90 M.C. 14" Black Spruce 8" White Birch 13" Cedar Dbl. White Birch

LEGEND:

Found 6" Dia. Concrete Mon. W/Stamped Brass Cap

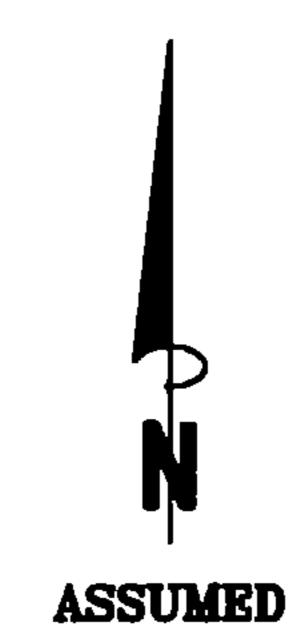

TO SCALE


NOTE: MEASUREMENTS MADE TO NAIL IN SIDE OF TREE.



Michael A. Treml, RLS

(type or print name) certify that the corner location shown on this record was determined by me or under my direction and control and that this U.S. Public Land Survey Monument Record is correct and complete to the best of my knowledge and belief.

7-20-01 Signature

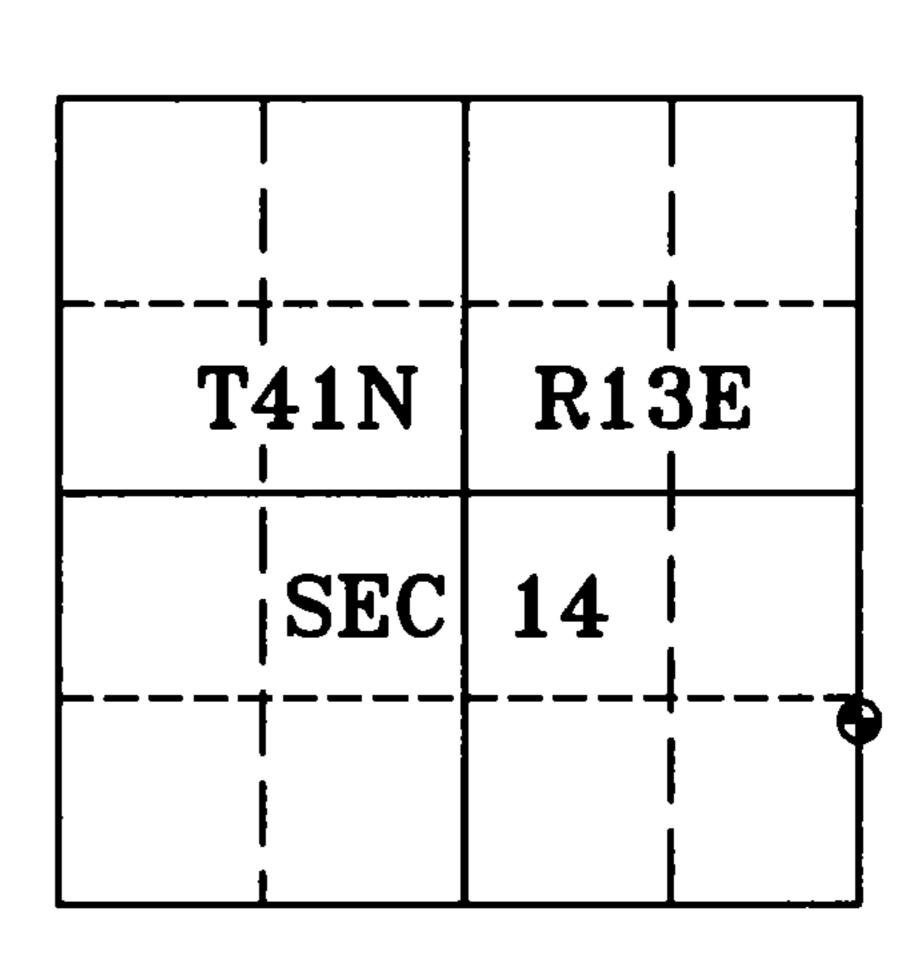

Meander The corner of Section 14 T. 41 N., R. 13 E. Forest County, WI

Index No. M,N-21