FILED ON: 07/05/2024 02:07 PM

CORTNEY BRITTEN CLEEREMAN REGISTER OF DEEDS FOREST COUNTY WI PAGES: 1

INDEX#: 025

U S PUBLIC LAND SURVEY MONUMENT RECORD

A-E 7.08(3)(a) Identity of corner. MEANDER CORNER EAST LINE OF SECTION 24, TOWNSHIP 41 NORTH, RANGE 13 EAST OF THE 4TH PM, TOWN OF ALVIN, COUNTY OF FOREST WISCRS - FOREST COUNTY N: 735,185.653 USft (XXX,XXX,XXX) E: 860,352.149 USft (XXX,XXX.XXX) Datum: NAD83 (2011) **GNSS Method RTK GNSS Control WISCORS VRS**

The coordinate value shown has been verified by the average of two or more GPS observations at a markedly different time. Coordinates shown in parenthesis are previously published values.

A-E 7.08(3)(b)

SIGNATURE

Original Surveyor: William E. Daugherty - June 5, 1865 to June 5, 1865 Cedar 12 - S 64° E - 12 Links & Tamarac - 14 - S 67° W - 18 Links


See Forest County Surveyor File #411324 1997 - 1977 - Surveyor 802 - Jean F. Resvick - THENCE:

March 7, 2011 - Surveyor 809 - Michael S. Hess - indicates this position as "USFS brass cap found" on Forest County Certified Survey Map volume CS-8 Certifled Surveys, on Page 149.

January 08, 2024 - I found a 4" diameter concrete monument with a 2.5" diameter, stamped brass cap. I also found 2 of Resvick's Bearing

I established 1 new reference monuments as shown below.

A-E 7.08(3)(c)(d) Plan view of corner with references to at least 4 witness monuments.

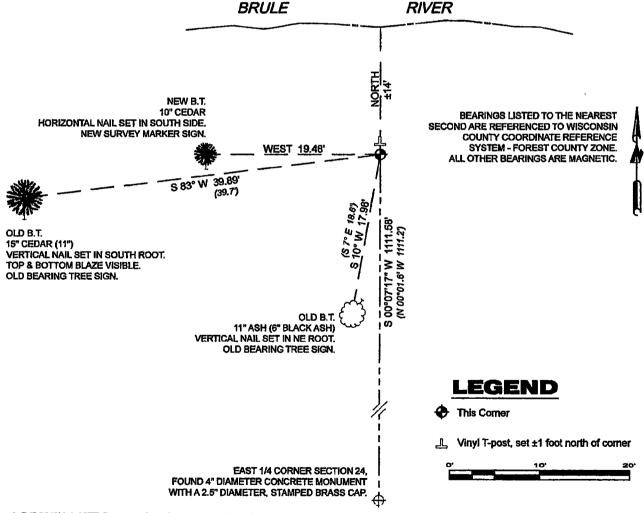

A-E 7.08(3)(e) 1977 Surveyor found a monument previously established by the BLM dependent resurvey, subsequent surveyor found a USFS brass cap. I found a 4" diameter concrete monument with a 2.5" diameter, stamped brass cap.

A-E 7.08(3)(f) I accept this monument as a FOUND PERPETUATED LOCATION of the corner. A-E 7.08(3)(g)(h) This corner was determined through lost-corner-proportionate methods.

A-E 7.08(3)(i) I, Jeffrey L. DeMuth, Professional Land Surveyor No. S-2656, hereby certify that the corner location on this record was determined by me or under my direction and control, and that this U.S. Public Land Survey Monument Record is correct and complet the best of my knowledge, and belief.

January 09, 2024

DATE

SCONS

effrey DeMuth S 2656

M