


U.S. PUBLIC LAND SURVEY MONUMENT RECORD

Index No. R-19,20

State of Wisconsin }
 County of Forest } ss.

I, Gary L. Pisoni, do hereby certify that on the 24th day of July, 1991, I found evidence of the Meander Corner ~~corner~~ between Sections 23 and 26 Township 41 North, Range 14 East, Fourth Principal Meridian, as described hereon; and that from this evidence I established a new monument and accessories as described hereon to perpetuate the original location of this corner.

Resident witnesses:

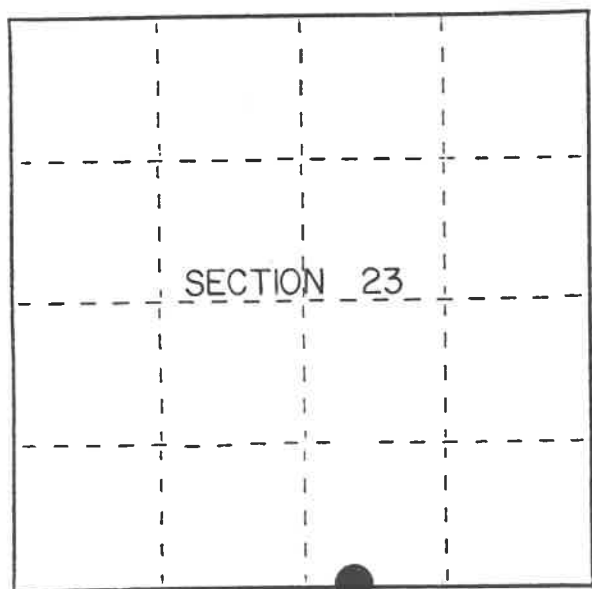

● = Corner monument restored.

History of original corner establishment:
 Original Government Survey in 1865 by William E. Daugherty. West corrected between Sections 23 and 26, at 31.50 chs. set Meander Post to Sections 23 and 26, from which the following bear;
 Tamarack 6" N34°E 11 lks.

At 40.00 chs., set Quarter Section Post to Sections 23 and 26 after leaving Right Bank of Brule River.

Description of corner evidence found:
 No original corner evidence was recovered.

I restored the Meander Corner position on the East bank of the Brule River according to the original field notes. Said notes called for the Section Line to run across 8.50 chs. of open water, and then intersect the South bank of Brule River and set Quarter Corner position. The definite direction of the river was used in determining the location of this corner, and is the best available evidence for restoring this corner.

Description of monument and accessories I established to perpetuate the original location of this corner.
 At the corner position, set a 2½ inch diameter aluminum pipe monument, 3 feet long, 3 inches above the ground, with an aluminum cap stamped; T41N R14E, M.C., S23, S26, 1991, S-1634. From which the following new blazed and scribed bearing trees bear;
 (measurements taken to a nail in side of tree)

| | | | |
|-----------------|-----|-------|------------|
| Balsam | 6" | N63°E | 26.45 feet |
| W. Spruce | 12" | S28°E | 2.72 feet |
| W. Spruce | 13" | S26°W | 23.68 feet |
| Steel Sign Post | | West | 0.82 feet |

Monument is 6 feet from river bank.

Dated at Iron River, MI, Wis. this 16th day of February, 1992

Signature Gary L. Pisoni Title Land Surveyor Registration No. S-1634
 (County Surveyor, Registered Land Surveyor, or other duly authorized official)

Office of Register of Deeds, County of Forest, I hereby certify that the within instrument was filed in this office for record on the 10th day of March, 1993 at 10:45 o'clock A.M.

J. Paul Aschebrenner
 (Register of Deeds)

By _____ Deputy

FORM NO. 985-A
 H.C. Miller Company
 Landmark Products

Stock No. 26273

146877

44114230017

