

CERTIFIED LAND CORNER RESTORATION

State of Wisconsin }
County of Forest } ss.

I Jean F. Resvick, do hereby certify that on the 25th day of May, 1965, I found evidence of the Northwest section corner of Section 33 Township 41 North, Range 14 East, Fourth Principal Meridian, as described hereon; and that from this evidence I established a new monument and accessories as described hereon to perpetuate the original location of this corner:

Description of original monument and accessories and subsequent restorations:

- North 80.00 chains between sections 32 & 33
Set wood post for section corner of sections 28, 29, 32 and 33
Sugar 10", N39°W, 15 lks.
Hemlock 8", S17°E, 13 lks.

U.S. Forest Service 874-9 form, dated 12/5/38, and signed by Alvin A. Snyder. Found cedar post from which the follow bear:


- 1. 16 inch scribed hemlock stub bears S5° 15' E, 10 lks. dist.
2. 10 inch hemlock bears N87° 15' E, 21 lks. dist.
3. 18 inch elm bears N29°, 31 lks. dist.

Description of corner evidence found:

Louis W. Verch, State Land Commission Forester, showed us the location of this corner which he had marked with a cherry post in 1964. Old cedar post and point found alongside of cherry post. Hemlock stump remains bear S5° 15' E, 6.60 ft. Hemlock stump bears N87° 15' E, 13.86 ft. Elm stump bears N29°W, 20.46 ft. Sugar stump bears N39°W, 9190 ft.

Description of monument and accessories I established to perpetuate the original location of this corner:


Replaced post with 2 inch inside diameter, galvanized wrought iron pipe, 5 feet long, filled with concrete, flanged at bottom with brass cap marked:

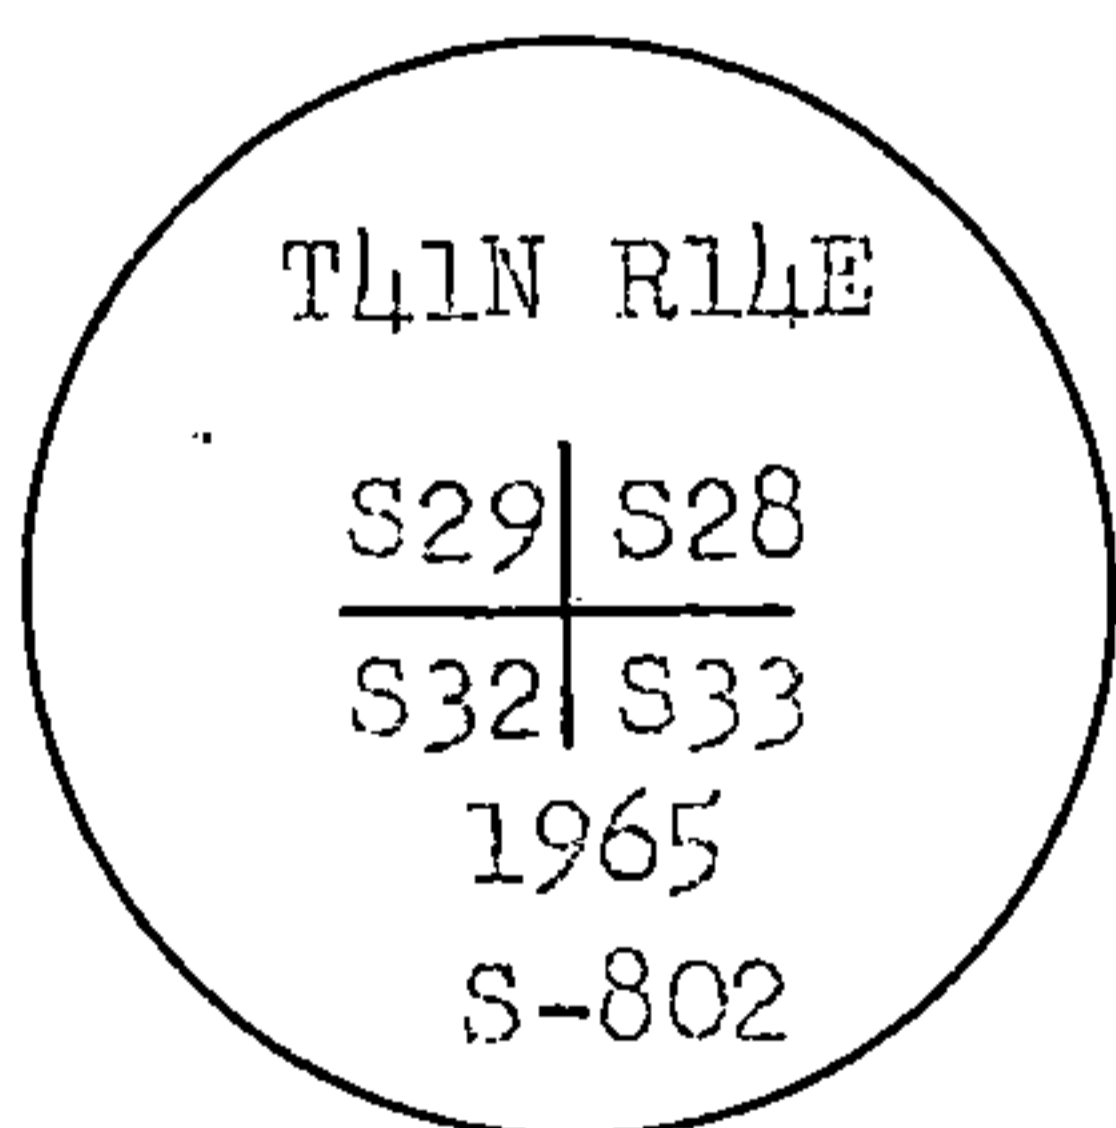

44114290000

from which the following blazed and scribed new bearing trees bear:

- 1. Elm 3", N36°E, 60.50 ft. or 9167 lks.
2. Elm 4", S46°E, 32.06 ft. or 48.58 lks.
3. Sugar 11", N89°W, 29.51 ft. or 44.71 lks.

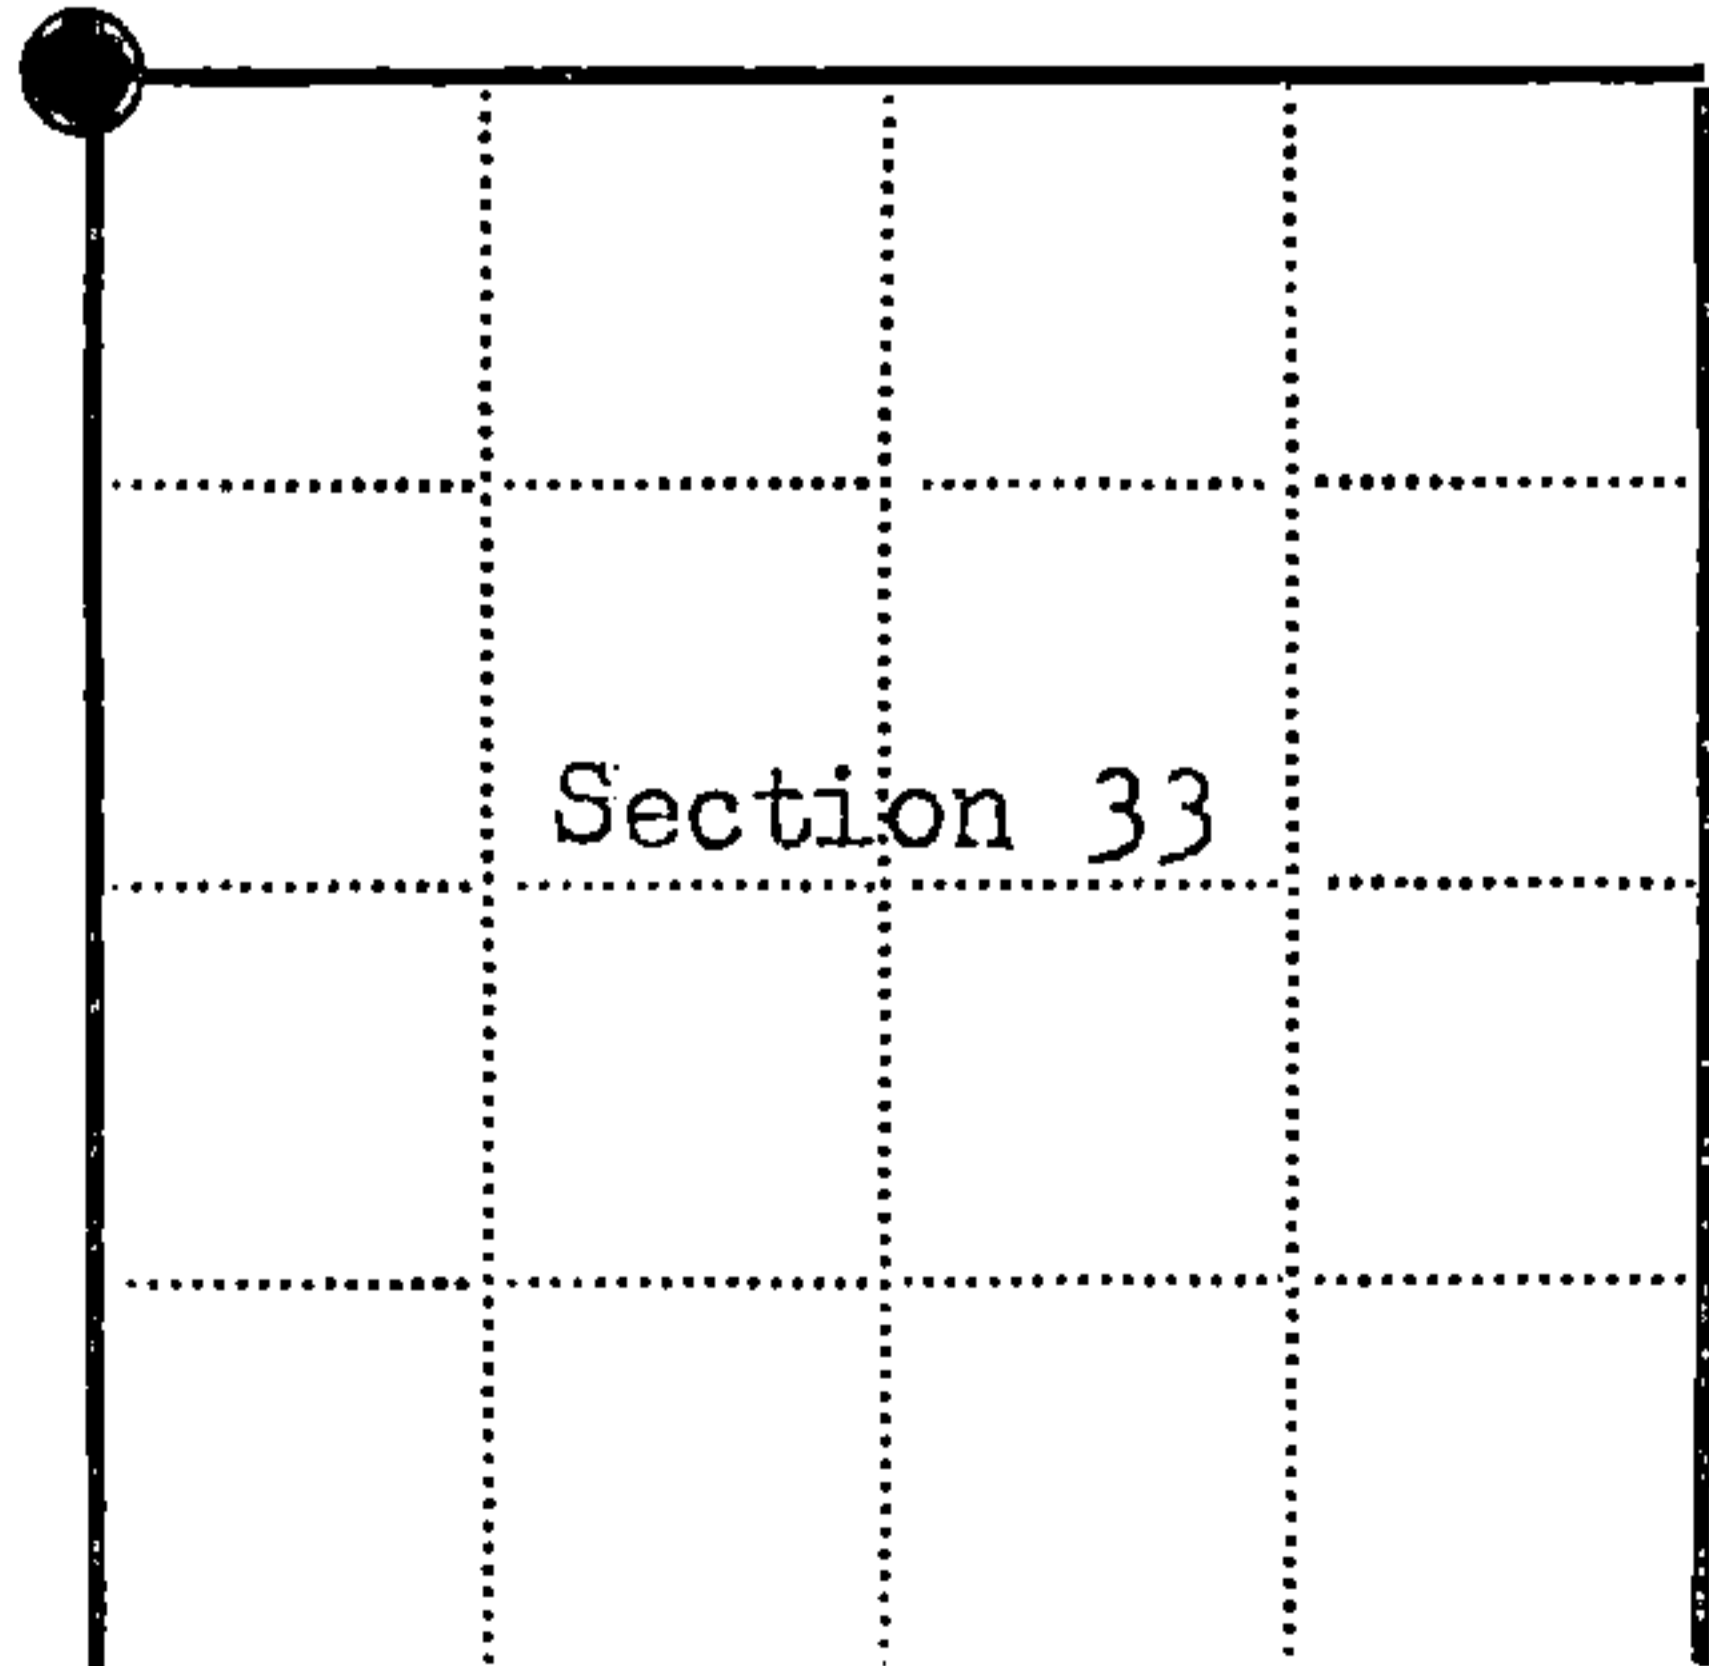

● = Corner monument restored
□ =

Resident witnesses Louis W. Verch, State Forester

Dated at Rhinelander, Wisconsin, this 21st day of March 1967.

Signature Jean F. Resvick Title: Professional Land Surveyor (County Surveyor, Registered Land Surveyor, or other duly authorized official)

Surveyors Registration No. S-802

DOCUMENT NO. 94240

Office of Register of Deeds County of Forest

I hereby certify that the within instrument was filed in this office for record on the 27th day of February 1968, and was filed in Book No. I Page No. of County Records.

Signature Eugene Staszny Title Register of Deeds

Township 41 North, Range 14 East, Section 33, Index No. V-9, Page No.



Handwritten marks and numbers at the bottom right corner.