



Green Lines — Correct Location —
 Red Lines — Present Stake Locations — (WRONG)

PART OF
 GOV'T. LOT 3,
 SECTION 27,
 TOWNSHIP 37 NORTH,
 RANGE 12 EAST

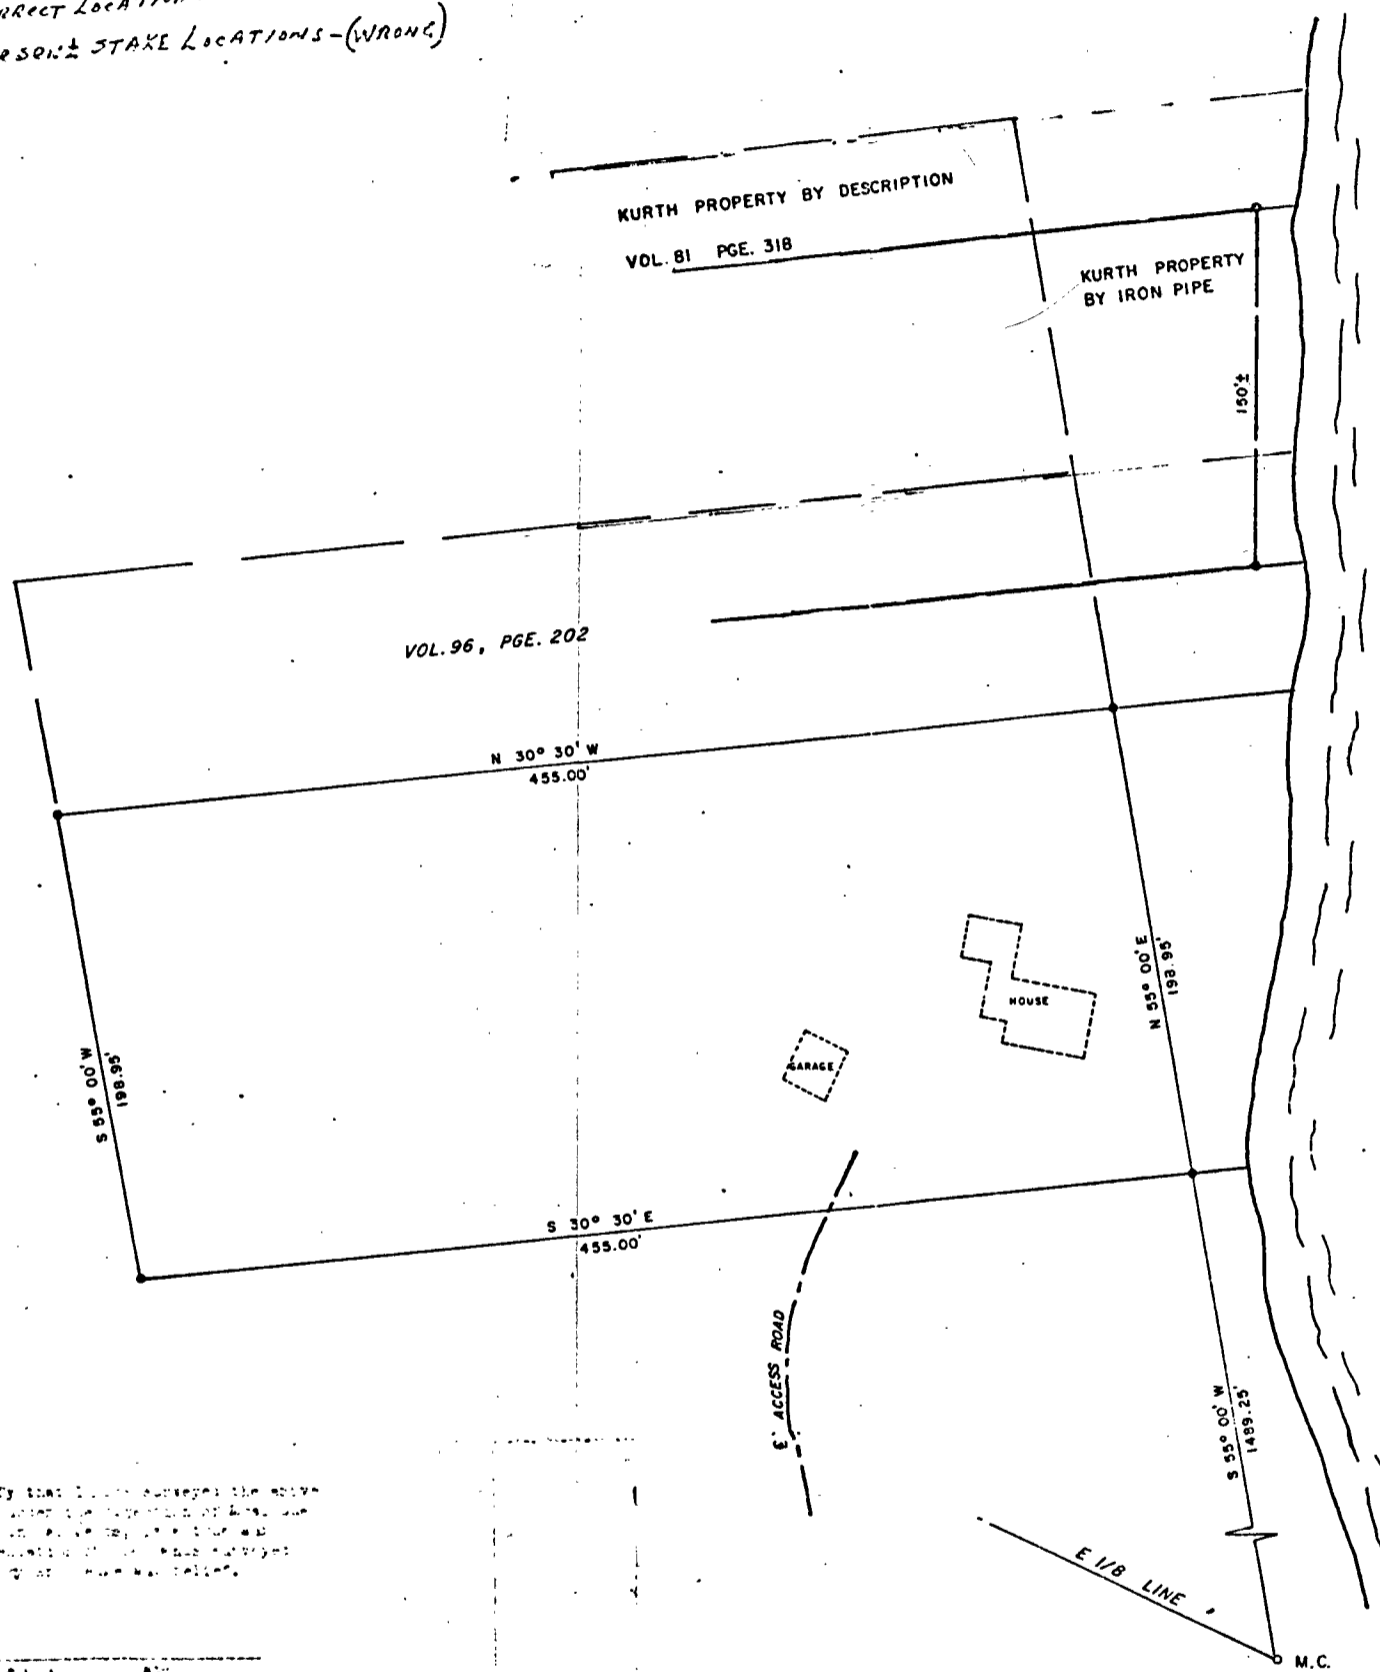

I hereby certify that I am a duly licensed surveyor in the State of Wisconsin and that the foregoing is a true and correct copy of the original field notes and computations of the above described survey.

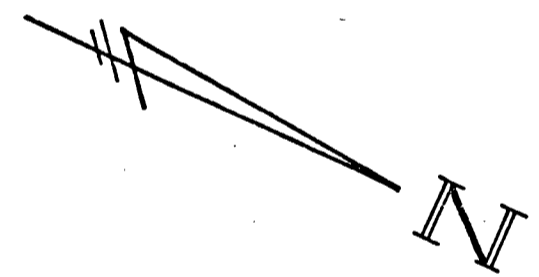

- LEGEND**
- EXISTING IRON PIPE
 - SET 1" x 30" IRON PIPE

SUE CLARK	
SCALE 1" = 50'	DATE 7-13-90
DWG. NO. 7132	GENISOT AND ASSOCIATES, INC. RHINELANDER, WIS.

FOREST CO SURVEYOR
 FILE # 371227-19800713
 DATE _____ BY _____