Electronically Filed on 5/5/2026
Forest County Land Information Office

U.S. PUBLIC LAND SURVEY MONUMENT RECORD

NOTE: This form is intended and designed to fufill all requirements of Wisconsin Administratvie Code, Chapter A-E 7.08 U.S. Public Land Survey Monument Record (3) (a-i)

A-E 7.08(3)(a) Identity of corner:
South 1/4 Corner Section 32,
Township 37 North, Range 13 East
of the Fourth Principal Meridian,
Town of Argonne, Forest County, Wisconsin

WISCRS - FOREST COUNTY
N: 595,054.430 USft (XXX,XXX.XXX)
E: 838,595.407 USft (XXX,XXX.XXX)
Datum: NAD83 (2011)
GNSS Method RTN
GNSS Control WISCORS VRS

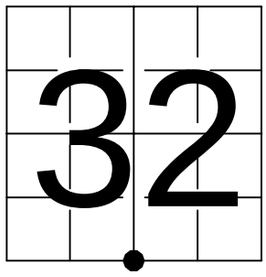

The coordinate value shown has been verified by the average of two or more GPS observations at a markedly different time. Coordinates shown in parenthesis are previously published values.

A-E 7.08(3)(b)

Original Surveyor: Alfred Millard - May, 1858 to June, 1858
Lynn 10 - N 13° E, 30 Links, Sugar 10 - S 68° W, 21 Links

See previous U.S.Public Land Survey Monument Record - A-7 - June 11, 2002 - Surveyor 2197 - Michael A. Treml - THENCE:

- February 16. 2019 - Surveyor 809-8 - Micheal S. Hess - indicates this position as "aluminum monument" on county record Map #371332-20190216.
- April 15. 2020 - Surveyor 809-8 - Micheal S. Hess - indicates this position as "Forest County monument". on county record Map #361305-20200415.

April 1, 2026 - I found a 2.4" diameter aluminum pipe monument with a 3.25" diameter aluminum cap stamped to identify the corner location. The monument is near the south edge of an east-west woods road and flush with grade. I also found 4 of Treml's bearing trees alive and in good condition. I established 0 new reference monuments as shown below. North

A-E 7.08(3)(c)(d) Plan view of corner with references to at least 4 witness monuments.

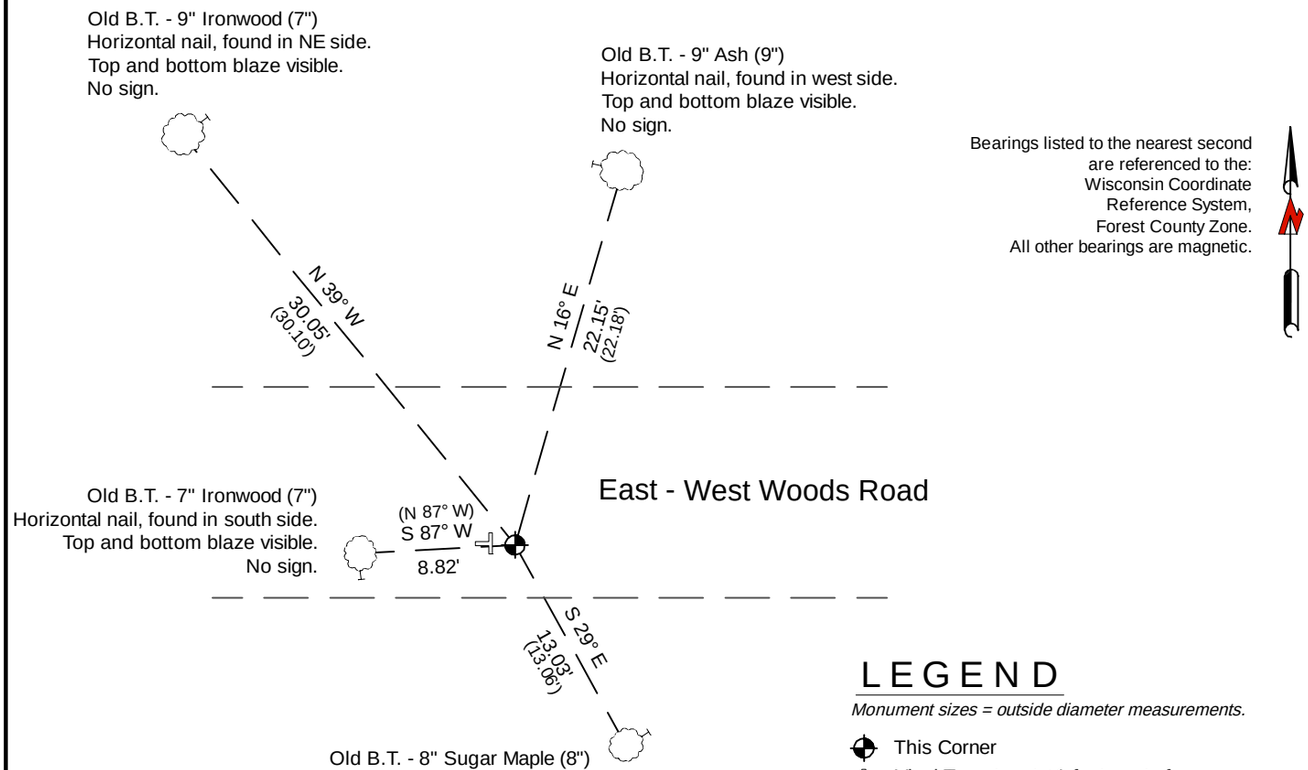

Bearings listed to the nearest second are referenced to the: Wisconsin Coordinate Reference System, Forest County Zone. All other bearings are magnetic.

LEGEND

Monument sizes = outside diameter measurements.

- This Corner
- Vinyl T-post, set ±1 foot west of corner
- Galvanized nail, set or nail found as shown

0' 10' 20'

A-E 7.08(3)(e) 1858 Surveyor set a post, 2002 Surveyor found and accepted "a 2" diameter by 36" long iron pipe". He replaced the pipe with a 2 1/2" diameter Forest County aluminum monument, subsequent surveyors found the same, as did I in 2026.

A-E 7.08(3)(f) I accept this monument in good faith as a FOUND PERPETUATED LOCATION of the corner.
A-E 7.08(3)(g)(h) This corner was not determined through lost-corner-proportionate methods.

A-E 7.08(3)(i) I, Jeffrey L. DeMuth, Professional Land Surveyor No. S-2656, hereby certify that the corner location on this record was determined by me or under my direction and control, and that this U.S. Public Land Survey Monument Record is correct and complete to the best of my knowledge, and belief.

WISCONSIN
Jeffrey DeMuth
S 2656
Arbor Vitae
WI
LAND SURVEYOR

SIGNATURE

April 2, 2026
DATE

43713320020

43713320020

REGISTER'S OFFICE
Forest County, Wis.
Received for record this 18th day of June A.D., 2002 at 4:00 o'clock P M, and recorded in Vol. Corner Restoration page A-7
Kay Swanson, Deputy
Register of Deeds

Document Number
175892

U.S. PUBLIC LAND SURVEY MONUMENT RECORD

(As Required by WI Adm. Code)

History of original corner establishment and subsequent restorations and descriptions of any record, monument, occupational, testimonial or other evidence considered:

1858 – Alfred Millard, set original corner post and made the following B.T.'s:
Lynn, 10", N 13° E, 30 lks., 19.80 feet.
Sugar, 10", S 68° W, 21 lks., 13.86 feet.

2002 – I found no evidence of the original corner post or accessories. I found a 2" diameter by 36" long Iron Pipe in E–W dirt road & along an old fence line running North. I accepted the iron pipe as the best available evidence of the corner position. I Replaced the existing iron pipe with a 2 1/2" diameter Forest County Aluminum Monument stamped for the 1/4 corner.

Corner was: (Check All That Apply)
__ Restored through acceptance of an obliterated evidence location.
X Restored through acceptance of a found perpetuated location.
__ Considered a lost corner and reestablished through lost corner proportionate methods (include a plan view drawing showing distances and directions to other Public Land Survey Corners used for proportioning and determining the corner location).
__ Restored or reestablished in a location that differs from a previous restoration or reestablishment (include a plan view drawing and indicate what was set and/or found).

Describe the monument and accessories used to perpetuate the location of this corner (include a plan view drawing and indicate what was set and/or found).

LEGEND:
● Forest County Aluminum Monument
—X—X— Barb wire fence

Note: All distances are taken to nail in side of tree.

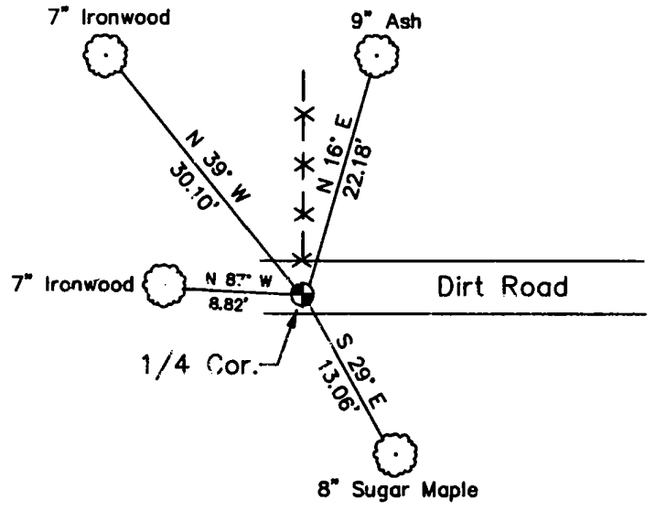

Land Surveyor Seal
WISCONSIN
MICHAEL A. TREML
S-2197
LAONA
WI
LAND SURVEYOR

ASSUMED

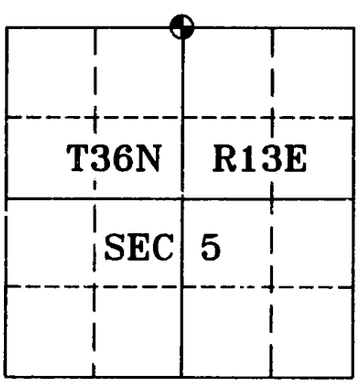

I, Michael A. Treml, RLS
(type or print name) certify that the corner location shown on this record was determined by me or under my direction and control and that this U.S. Public Land Survey Monument Record is correct and complete to the best of my knowledge and belief.

Michael A Treml 6/11/02
Signature Date

The North Quarter corner of Section 5 T. 36 N., R. 13 E. Forest County, WI

Index No. A–7

4371332 0020