Electronically Filed on 8/31/2026
Forest County Land Information Office

U.S. PUBLIC LAND SURVEY MONUMENT RECORD

NOTE: This form is intended and designed to fufill all requirements of Wisconsin Administratvie Code, Chapter A-E 7.08 U.S. Public Land Survey Monument Record (3) (a-i)

A-E 7.08(3)(a) Identity of corner:
East 1/4 Corner Section 31,
Township 35 North, Range 15 East
of the Fourth Principal Meridian,
Town of Wabeno, Forest County, Wisconsin

WISCRS - FOREST COUNTY
N: 534,461.131 USft (XXX,XXX.XXX)
E: 899,579.875 USft (XXX,XXX.XXX)
Datum: NAD83 (2011)
GNSS Method RTN
GNSS Control WISCORS VRS

31

The coordinate value shown has been verified by the average of two or more GPS observations at a markedly different time. Coordinates shown in parenthesis are previously published values.

A-E 7.08(3)(b)


Original Surveyor: James McBride - June 10, 1859 to June 15, 1859
Elm 24 - N 71° E, 25 Links, Birch 16 - N 73° W, 42 Links

See previous U.S.Public Land Survey Monument Record - X5 - December 24, 1984 - Surveyor 1558 - Milo E. Stefan - THENCE:

- September 13, 1985 - Surveyor 1098 - William F. Kelly - indicates this position as "aluminum cap mon., found in place" on county record Map #351531-19850913.
- January 3, 1992 - Surveyor 1259 - Kim H. Pritzlaff - indicates this position as "2" aluminum monument with stamped cap" on county record Map #351532-19920103.
- November 01, 2005 - Surveyor 2467 - Zachary J. Stevens - indicates this position as "FND. 3.5" Alum cap" on county record Map #351531-20051101.
- October 01, 2021 - Surveyor 2958 - Jesse L. Roberge - indicates this position as "found 2in O.D. iron pipe with aluminum cap" on county record Map #351531-20211001.
- May 14, 2002 - Surveyor 2197 - Michael A. Treml - indicates this position as "existing 2" dia. aluminum monument" on county record Map #351532-20020514.
- September 26, 2023 - Surveyor 1763 - Thomas A. Boetcher - indicates this position as "Forest County aluminum capped monument found in place" on county record Map #351531-20230926.

November 11, 2025 - I found a 2.4" diameter aluminum pipe monument with a 3.25" diameter aluminum cap stamped to identify the corner location. The monument is on high land, extends ±12" above grade, and is ±3" out of plumb leaning to the north(I shot the top of the monument). I also found 3 of Stefan's bearing trees alive and in good condition, and his steel sign post lying down under a fallen tree. I reset the steel sign post and established 1 new reference monuments as shown below.

A-E 7.08(3)(c)(d) Plan view of corner with references to at least 4 witness monuments.

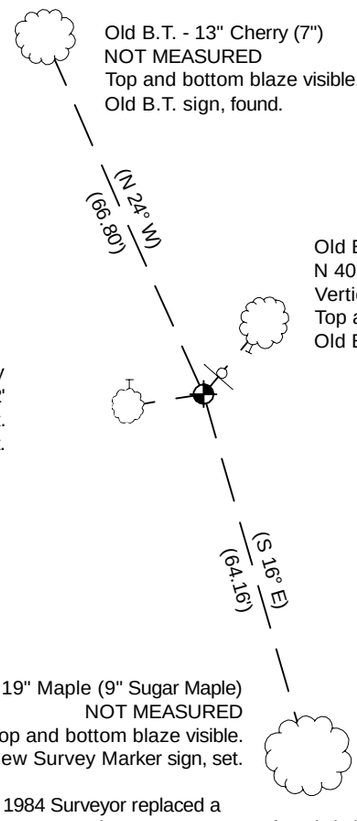

Bearings listed to the nearest second are referenced to the: Wisconsin Coordinate Reference System, Forest County Zone. All other bearings are magnetic.

LEGEND

Monument sizes = outside diameter measurements.

- This Corner
- Steel post, reset ±2.1 feet NE of corner
- Galvanized nail, set or nail found as shown

0' 30' 60'

A-E 7.08(3)(e) 1858 Surveyor set a post, 1984 Surveyor replaced a 2" iron pipe with a 2" x 30" aluminum monument, subsequent surveyors found similar, as did I in 2025.

A-E 7.08(3)(f) I accept this monument in good faith as a FOUND PERPETUATED LOCATION of the corner.
A-E 7.08(3)(g)(h) This corner was not determined through lost-corner-proportionate methods.

A-E 7.08(3)(i) I, Jeffrey L. DeMuth, Professional Land Surveyor No. S-2656, hereby certify that the corner location on this record was determined by me or under my direction and control, and that this U.S. Public Land Survey Monument Record is correct and complete to the best of my knowledge, and belief.

WISCONSIN
Jeffrey DeMuth
S 2656
Arbor Vitae
WI
LAND SURVEYOR

SIGNATURE

November 26, 2025
DATE

43515312000

43515312000