U.S. PUBLIC LAND SURVEY MONUMENT RECORD

(As Required By WI Adm. Code)

Index No. A – 11
2026

History of original corner establishment and subsequent restorations and description of any record, monument, occupational, testimonial or other evidence considered:

1857 – Original Government Survey by Artemas Curtis.

1980 – Paul Smith found a pile of rock and remains of an old wood stake as set by N. H. Smith in 1899 at the time of the Carter Plat to the north. He also found a hemlock stump to the southeast that fit government bearing tree dimensions. He accepted the stake as the corner and set a Cast Aluminum Oconto County Monument at this location. He also set three, 1" Iron Pipe as accessories at this time.


1988 – Kim Pritzlaff, surveyor for the US Forest Service, found Smith's monument in good condition. He accepted the monument as the corner and took 4 new bearing trees at this time and filed a new tie sheet.

2025 – I found Smith's monument in good condition, one of his iron rods, and all of Pritzlaff's BT's. I accept the monument as the corner and and set four 1" iron rod accessories as shown in the sketch.

Corner was: (Check All That Apply)

- X Restored through acceptance of an obliterated evidence location.
- X Restored through acceptance of a found perpetuated location.
- — Considered a lost corner and reestablished through lost corner proportionate methods (include a plan view drawing showing distances and directions to other Public Land Survey Corners used for proportioning and determining the corner location).
- — Restored or reestablished in a location that differs from a previous restoration or reestablishment (include a plan view drawing and indicate what was set and/or found).

Describe the monument and accessories used to perpetuate the location of this corner (include a plan view drawing and indicate what was set and/or found).

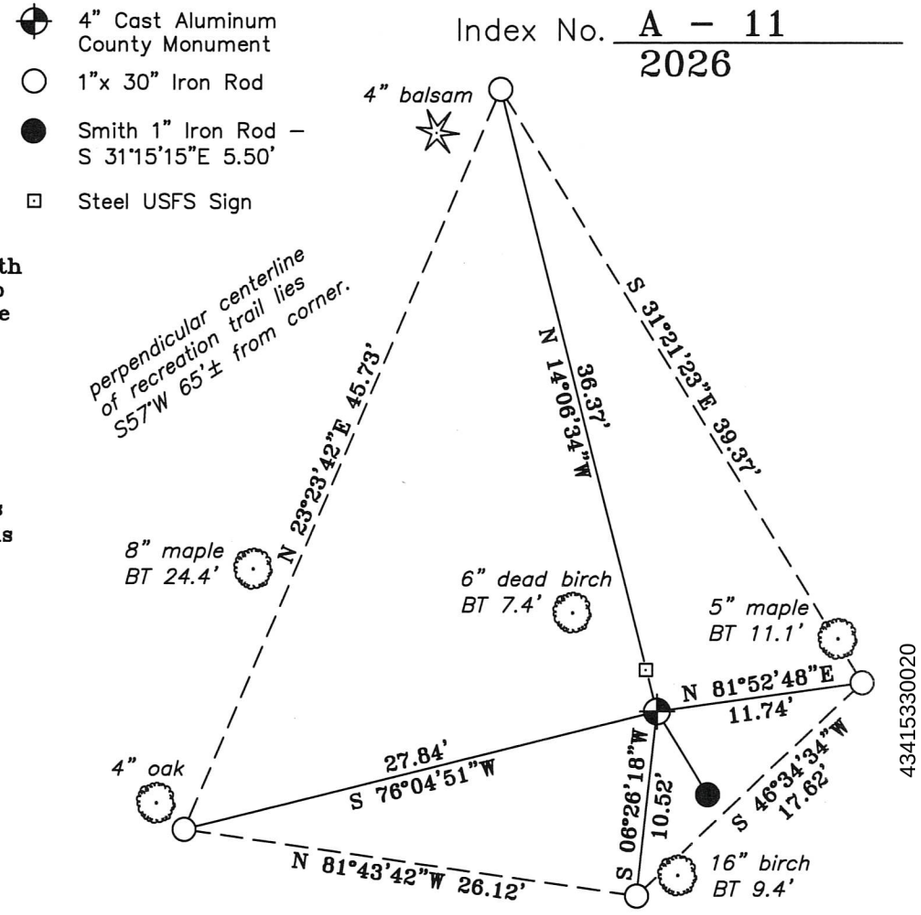

43415330020

I, **Brian B. Gross S-2490**
(type or print name) certify that the corner location shown on this record was determined by me or under my direction and control and that this U. S. Public Land Survey Monument Record is correct and complete to the best of my knowledge and belief.


Brian B. Gross 6-29-26
Signature Date

WISCONSIN BRIAN B. GROSS S-2490 OCONTO COUNTY SURVEYOR LAND SURVEYOR BBG

Land Surveyor Seal

WCCS OC
Scale 1"=10'

The **North Quarter** corner of Section 4 T. 33 N., R. 15 E. Oconto County, WI

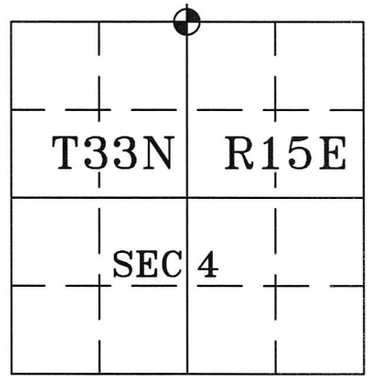

Electronically Filed on 7/10/2026
Forest County Land Information Office