U.S. PUBLIC LAND SURVEY MONUMENT RECORD

(As Required By WI Adm. Code)

Index No. A – 25
2026

History of original corner establishment and subsequent restorations and description of any record, monument, occupational, testimonial or other evidence considered:

1857 – Original Government Survey by Artemas Curtis.


1984 – Milo Stefan, surveyor for the US Forest Service, searched for evidence of this corner and using natural feature calls was able to find a birch stump. At N46°E 7.92' he found the post hole from the original corner. Northwest from there, at the correct bearing and distance based on the original government survey, he found another birch stump. This proved the post hole location for the corner. He set a 2" aluminum monument stamped to identify the corner. He also set a new sign post and took 4 new bearing trees at this time.

2024 – I found Stefan's monument, sign post, and bearing trees in good condition. I accept the monument as the corner location and set additional accessories as shown in the sketch.

Corner was: (Check All That Apply)

- X Restored through acceptance of an obliterated evidence location.
- X Restored through acceptance of a found perpetuated location.
- — Considered a lost corner and reestablished through lost corner proportionate methods (include a plan view drawing showing distances and directions to other Public Land Survey Corners used for proportioning and determining the corner location).
- — Restored or reestablished in a location that differs from a previous restoration or reestablishment (include a plan view drawing and indicate what was set and/or found).

Describe the monument and accessories used to perpetuate the location of this corner (include a plan view drawing and indicate what was set and/or found).

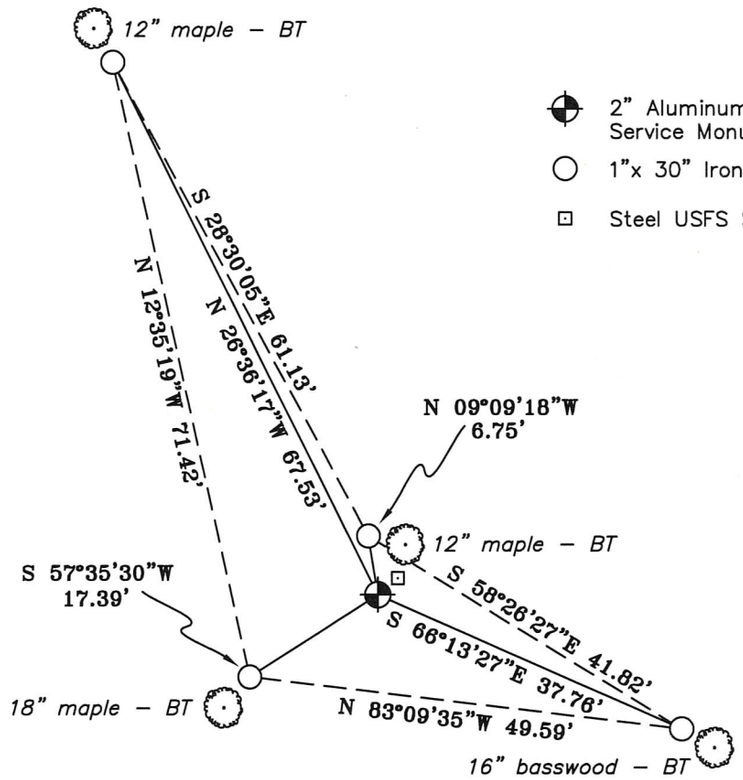

4345360000

I, Brian B. Gross S-2490
(type or print name) certify that the corner location shown on this record was determined by me or under my direction and control and that this U. S. Public Land Survey Monument Record is correct and complete to the best of my knowledge and belief.


Brian B. Gross 4-28-2026
Signature Date

WISCONSIN
BRIAN B. GROSS
S-2490
OCONTO COUNTY SURVEYOR
LAND SURVEYOR

Land Surveyor Seal

WCCS OC
Scale 1"=20'

The Northeast corner of
Section 1 T. 33 N., R. 15 E.
Oconto County, WI

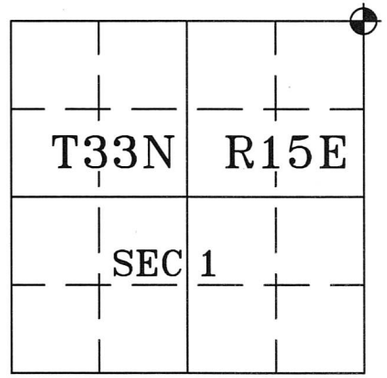

Electronically Filed on 7/10/2026
Forest County Land Information Office