Electronically Filed on 11/11/2026
Forest County Land Information Office

U.S. PUBLIC LAND SURVEY MONUMENT RECORD

NOTE: This form is intended and designed to fufill all requirements of Wisconsin Administratvie Code, Chapter A-E 7.08 U.S. Public Land Survey Monument Record (3) (a-i)

07

A-E 7.08(3)(a) Identity of corner:
Meander Corner, South line Section 07,
West shore of Metonga Lake
Township 35 North, Range 13 East
of the Fourth Principal Meridian,
Town of Lincoln, Forest County, Wisconsin

WISCRS - FOREST COUNTY
N: 553,281.375 USft (XXX,XXX.XXX)
E: 834,106.624 USft (XXX,XXX.XXX)
Datum: NAD83 (2011)
GNSS Method RTN
GNSS Control WISCORS VRS

The coordinate value shown has been verified by the average of two or more GPS observations at a markedly different time. Coordinates shown in parenthesis are previously published values.

A-E 7.08(3)(b)


Original Surveyor: James L. Nowlin - September 11, 1865 to September 21, 1865
Hemlock 15 - S 56° W, 6 Links, Cedar 12 - N 65° W, 15 Links

THENCE:

- October 11, 2006 - Surveyor 2197 - Michael A. Treml - indicates that he set 2 – 3/4" x 24" rebar on line between Government Lot 4, Section 7, and Government Lot 2, Section 18 on county record Map #351318-20061011.
- November 6, 2007 - Surveyor 2197 - Michael A. Treml - indicates that he found 2 – 3/4"rebar on line between Government Lot 4, Section 7, and Government Lot 2, Section 18 on county record Map #351318-20071106.
- May 14, 2008 - Surveyor 2197 - Michael A. Treml - indicates that he found 2 – 3/4"rebar on line between Government Lot 4, Section 7, and Government Lot 2, Section 18 on county record Map #351318-20080514.

November 2, 2026 - While performing the 2026 - "PLSS Corner Remonumentation - Lincoln" project, I found Treml's 3/4" diameter iron rods.
I extended a line from the South 1/4 corner (found previously) to the west shore of Metonga Lake.
I set, on this line, a 1" diameter by 2.7 foot long aluminum pipe - drivable monument with a 3.25" diameter aluminum cap stamped to identify the corner location. The monument is on high ground, ±25' from the shore of Metonga Lake, ±3" below grade
I established 4 new reference monuments as shown below.

A-E 7.08(3)(c)(d) Plan view of corner with references to at least 4 witness monuments.

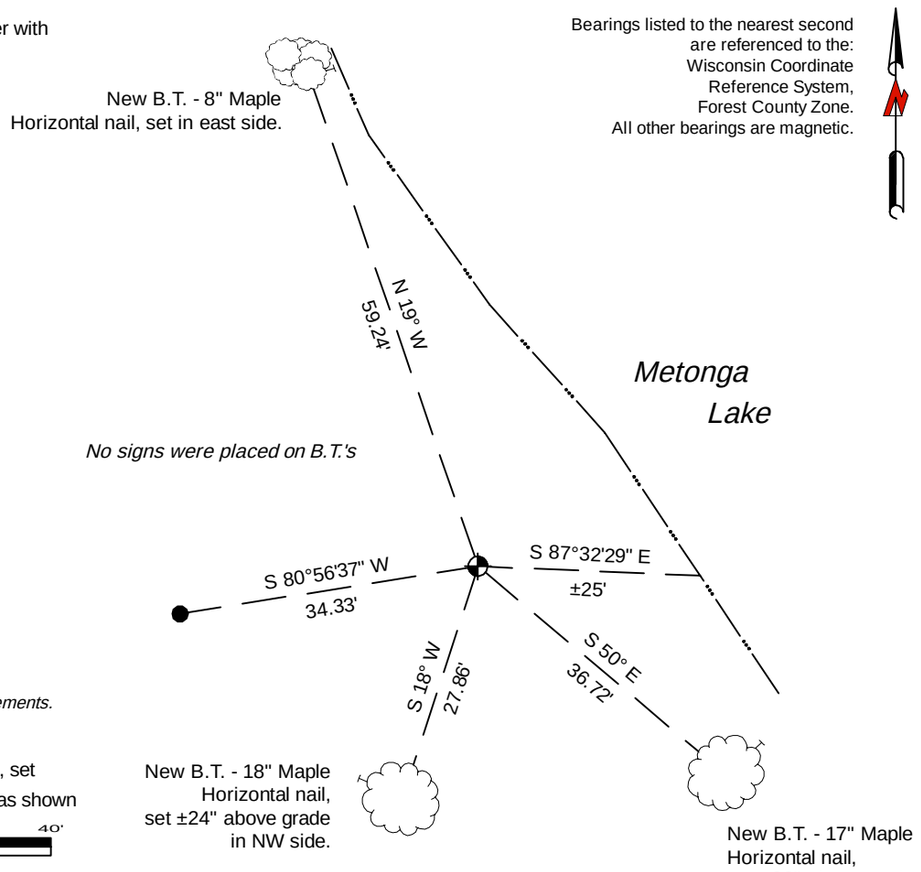

LEGEND

Monument sizes = outside diameter measurements.

- This Corner
- 0.75" diameter X 18" long iron rod, set
- Galvanized nail, set or nail found as shown

0' 20' 40'

A-E 7.08(3)(e) 1865 Surveyor set a post. I set a 1" diameter by 2.7 foot long aluminum pipe - drivable monument with a 3.25" diameter aluminum cap stamped to identify the corner location.

A-E 7.08(3)(f) I restored this corner through acceptance of an OBLITERATED EVIDENCE location.
A-E 7.08(3)(g)(h) This corner was not determined through lost-corner-proportionate methods.

A-E 7.08(3)(i) I, Jeffrey L. DeMuth, Professional Land Surveyor No. S-2656, hereby certify that the corner location on this record was determined by me or under my direction and control, and that this U.S. Public Land Survey Monument Record is correct and complete to the best of my knowledge, and belief.

WISCONSIN
Jeffrey DeMuth
S 2656
Arbor Vitae
WI
LAND SURVEYOR

November 11, 2026
SIGNATURE DATE

43513070018

43513070018