Electronically Filed on 11/11/2026
Forest County Land Information Office

U.S. PUBLIC LAND SURVEY MONUMENT RECORD

NOTE: This form is intended and designed to fufill all requirements of Wisconsin Administratvie Code, Chapter A-E 7.08 U.S. Public Land Survey Monument Record (3) (a-i)

A-E 7.08(3)(a) Identity of corner:
South 1/4 Corner Section 07,
Township 35 North, Range 13 East
of the Fourth Principal Meridian,
Town of Lincoln, Forest County, Wisconsin

WISCRS - FOREST COUNTY
N: 553,312.483 USft (XXX,XXX.XXX)
E: 833,382.092 USft (XXX,XXX.XXX)
Datum: NAD83 (2011)
GNSS Method RTN
GNSS Control WISCORS VRS

07

The coordinate value shown has been verified by the average of two or more GPS observations at a markedly different time. Coordinates shown in parenthesis are previously published values.

A-E 7.08(3)(b)

Original Surveyor: James L. Nowlin - September 11, 1865 to September 21, 1865
Hemlock 15 - S 62° E, 45 Links, Hemlock 12 - N 75° W, 30 Links


THENCE:

- December 4, 1989 – Surveyor 1098 – William F. Kelly – indicates this position as “1 1/4" iron pipe found in place” on Certified Survey Map document #139017.
- March 17, 1995 – Surveyor 1394 – Norman A. Harrison – indicates this position as “1 1/4" i.p.” on the Sandy Bay Plat.
- May 26, 2004 – Surveyor 1451 – Eugene C. Uttech – indicates this position as “1 1/4" iron pipe found” on county record Map #351318-20040526.
- October 11, 2006 - Surveyor 2197 - Michael A. Treml - indicates this position as “existing 1 1/2" iron pipe” on county record Map #351318-20061011.
- November 6, 2007 - Surveyor 2197 - Michael A. Treml - indicates this position as “existing 1 1/2" iron pipe” on county record Map #351318-20071106.
- May 14, 2008 - Surveyor 2197 - Michael A. Treml - indicates this position as “existing 1 1/2" iron pipe” on county record Map #351318-20080514.
- August 25, 2011 – Surveyor 2292 – Keith W. Walenski – indicates this position as “1 1/4" iron pipe” on Certified Survey Map document #207127.
- June 27, 2025 – Surveyor 2439 – Charles L. Oleinik - indicates this position as “found 1 1/2" iron pipe” on county record Map #351318-20250627.

October 30, 2026 - While performing the 2026 - "PLSS Corner Remonumentation - Lincoln" project, I found a 1.9" diameter iron pipe. The monument is on high ground and ±2" below grade.
I established 4 new reference monuments as shown below.

A-E 7.08(3)(c)(d) Plan view of corner with references to at least 4 witness monuments.

Bearings listed to the nearest second are referenced to the: Wisconsin Coordinate Reference System, Forest County Zone. All other bearings are magnetic.

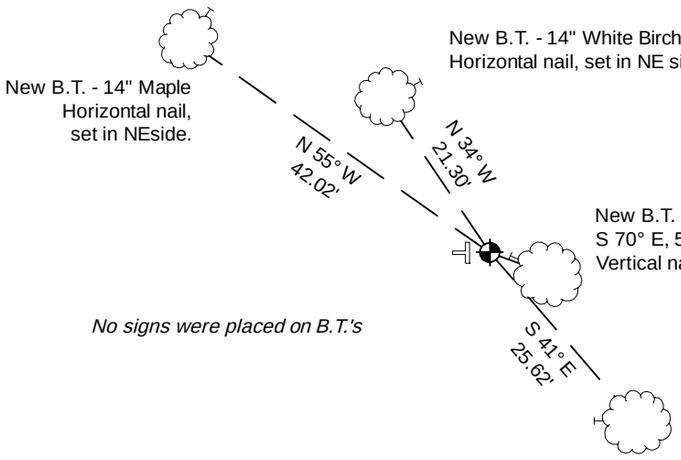

LEGEND

Monument sizes = outside diameter measurements.

- This Corner
- Vinyl T-post, set ±1.6 feet west of corner
- Galvanized nail, set or nail found as shown

0' 20' 40'

A-E 7.08(3)(e) 1865 Surveyor set a post, Subsequent Surveyors found an iron pipe. I found a 1.9" diameter iron pipe in 2026.

A-E 7.08(3)(f) I accept this monument in good faith as a FOUND PERPETUATED LOCATION of the corner.
A-E 7.08(3)(g)(h) This corner was not determined through lost-corner-proportionate methods.

A-E 7.08(3)(i) I, Jeffrey L. DeMuth, Professional Land Surveyor No. S-2656, hereby certify that the corner location on this record was determined by me or under my direction and control, and that this U.S. Public Land Survey Monument Record is correct and complete to the best of my knowledge, and belief.

WISCONSIN
Jeffrey DeMuth
S 2656
Arbor Vitae
WI
LAND SURVEYOR

November 11, 2026
SIGNATURE DATE

43513070020

43513070020