Electronically Filed on 11/11/2026
Forest County Land Information Office

U.S. PUBLIC LAND SURVEY MONUMENT RECORD

NOTE: This form is intended and designed to fufill all requirements of Wisconsin Administratvie Code, Chapter A-E 7.08 U.S. Public Land Survey Monument Record (3) (a-i)

10.

A-E 7.08(3)(a) Identity of corner:
Meander Corner, East line Section 10,
East shore of Lucerne Lake
Township 35 North, Range 13 East
of the Fourth Principal Meridian,
Town of Lincoln, Forest County, Wisconsin

WISCRS - FOREST COUNTY
N: 553,932.072 USft (XXX,XXX.XXX)
E: 851,893.179 USft (XXX,XXX.XXX)
Datum: NAD83 (2011)
GNSS Method RTN
GNSS Control WISCORS VRS

The coordinate value shown has been verified by the average of two or more GPS observations at a markedly different time. Coordinates shown in parenthesis are previously published values.

A-E 7.08(3)(b)

Original Surveyor: James L. Nowlin - September 11, 1865 to September 21, 1865
Birch 6 - N 66° E, 10 Links, Yellow Pine 15 - N 18° W, 25 Links


THENCE:

- August 29, 1974 - Surveyor 1098 - William F. Kelly - indicates this position as "meander corner 1 1/2" iron pipe found in place" on Certified Survey Map document #105965.
- August 1, 1984 – Surveyor 1107 – William B. Cochrane – indicates this position as “1.50” ID pipe set in 1908 by the Keith and Hiles Lumber Co. Surveyors” on county record Map#351311-19840801.

October 29, 2026 - While performing the 2026 - "PLSS Corner Remonumentation - Lincoln" project, I found a 2.5" diameter iron pipe. The monument is on high ground, ±8' from the shore of Lucerne Lake, extends ±8" above grade. I also found 2 of Kelly's B.T.'s alive and in good condition.
I established 2 new reference monuments as shown below.

A-E 7.08(3)(c)(d) Plan view of corner with references to at least 4 witness monuments.

Bearings listed to the nearest second are referenced to the: Wisconsin Coordinate Reference System, Forest County Zone. All other bearings are magnetic.

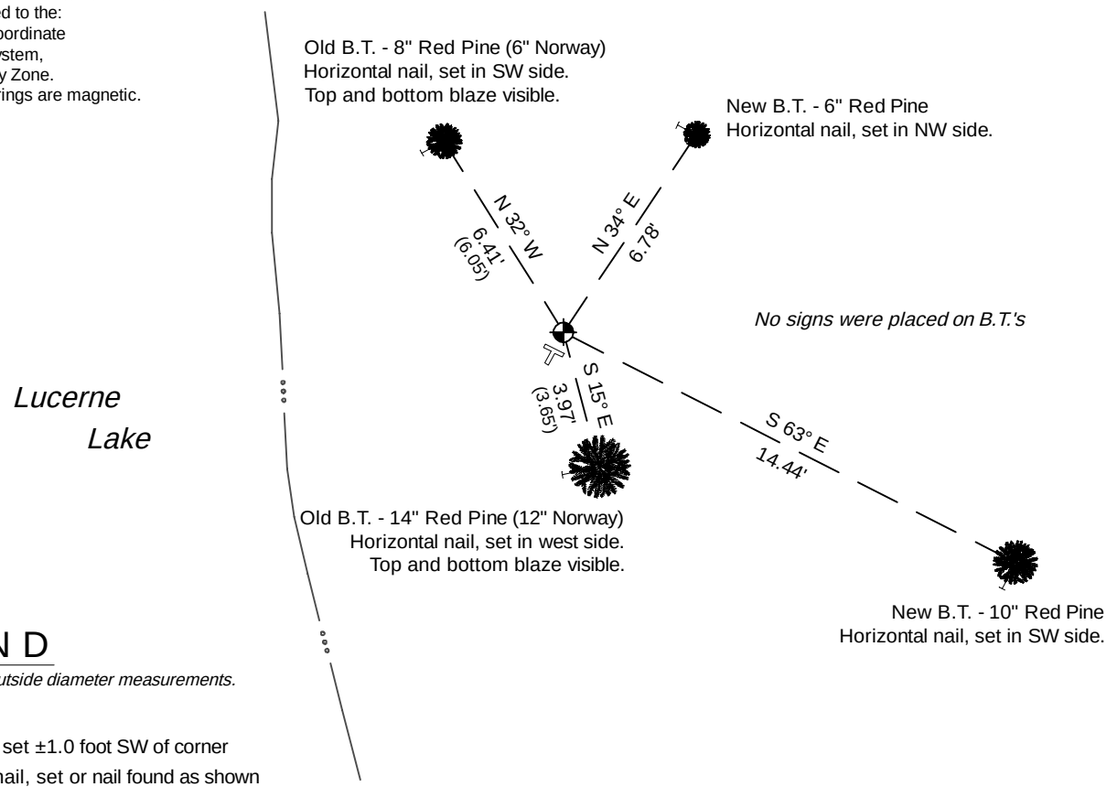

LEGEND

Monument sizes = outside diameter measurements.

- This Corner
- Vinyl T-post, set ±1.0 foot SW of corner
- Galvanized nail, set or nail found as shown

0' 5' 10'

A-E 7.08(3)(e) 1865 Surveyor set a post, 1974 and 1984 Surveyors found a 1.5" iron pipe. I found a 2.5" diameter iron pipe in 2026.

A-E 7.08(3)(f) I accept this monument in good faith as a FOUND PERPETUATED LOCATION of the corner.
A-E 7.08(3)(g)(h) This corner was not determined through lost-corner-proportionate methods.

A-E 7.08(3)(i) I, Jeffrey L. DeMuth, Professional Land Surveyor No. S-2656, hereby certify that the corner location on this record was determined by me or under my direction and control, and that this U.S. Public Land Survey Monument Record is correct and complete to the best of my knowledge, and belief.

WISCONSIN
Jeffrey DeMuth
S 2656
Arbor Vitae
WI
LAND SURVEYOR

November 9, 2026
SIGNATURE DATE

43513100600

43513100600