Electronically Filed on 11/11/2026
Forest County Land Information Office

U.S. PUBLIC LAND SURVEY MONUMENT RECORD

NOTE: This form is intended and designed to fufill all requirements of Wisconsin Administratvie Code, Chapter A-E 7.08 U.S. Public Land Survey Monument Record (3) (a-i)

A-E 7.08(3)(a) Identity of corner:
South 1/4 Corner Section 18,
Township 35 North, Range 13 East
of the Fourth Principal Meridian,
Town of Lincoln, Forest County, Wisconsin

WISCRS - FOREST COUNTY
N: 548,035.324 USft (XXX,XXX.XXX)
E: 833,374.822 USft (XXX,XXX.XXX)
Datum: NAD83 (2011)
GNSS Method RTN
GNSS Control WISCORS VRS

18

The coordinate value shown has been verified by the average of two or more GPS observations at a markedly different time. Coordinates shown in parenthesis are previously published values.

A-E 7.08(3)(b)


Original Surveyor: James L. Nowlin - September 11, 1865 to September 21, 1865
Fir 12 - S 22° E, 6 Links, Fir 12 - N 62° W, 20 Links

THENCE:

- February 18, 1993 - Surveyor 1394 - Norman A. Harrison - indicates this position as "set 1 1/4" x 30" iron pipe as temp marker" on county record Map #351319-19930218.
- May 26, 2004 - Surveyor 1451 - Eugene C. Uttech - indicates this position as "1 1/4" iron pipe found" on county record Map #351318-20040526.

October 14, 2026 - While performing the 2026 - "PLSS Corner Remonumentation - Lincoln" project, I found a 1.6" diameter iron pipe monument. The monument is in the west ditch line of Swamp Creek Lane and flush with grade.
I established 4 new reference monuments as shown below.

A-E 7.08(3)(c)(d) Plan view of corner with references to at least 4 witness monuments.

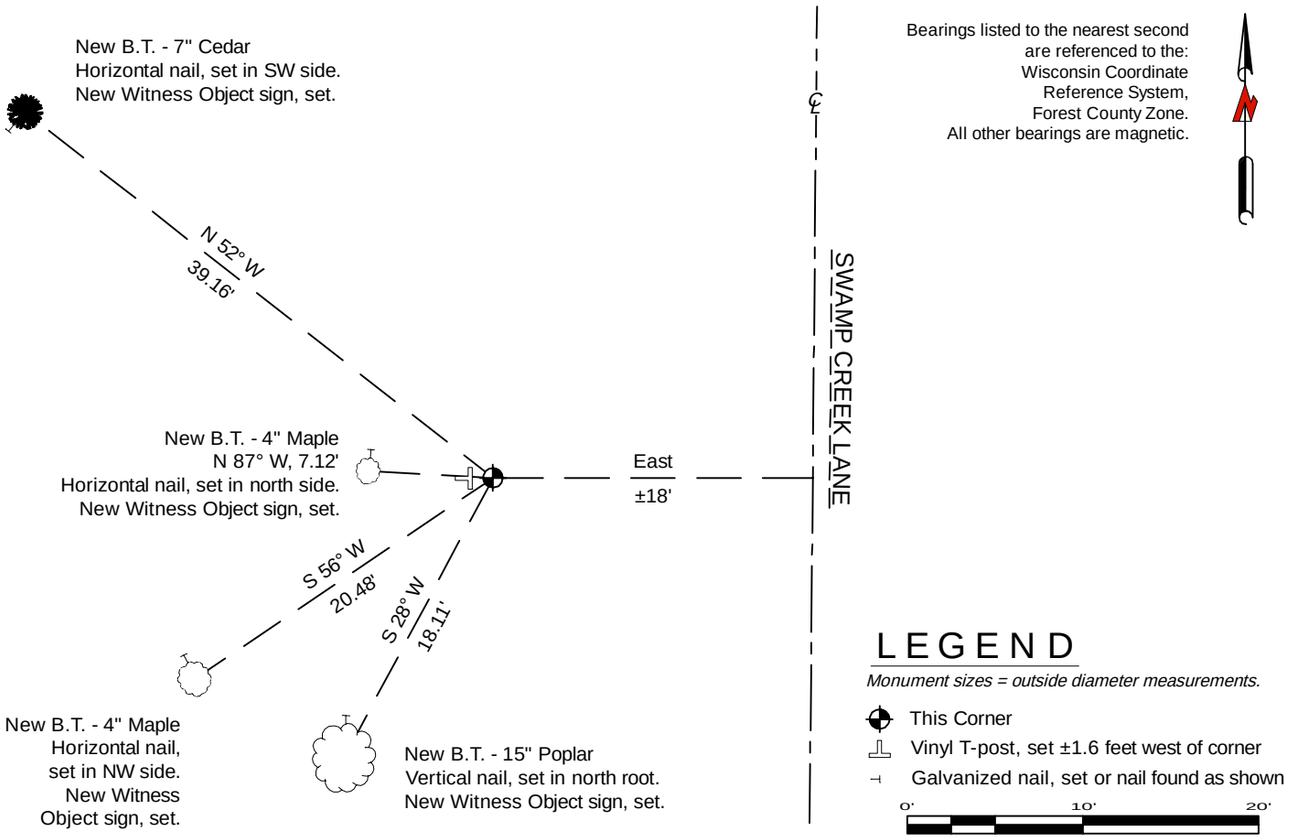

A-E 7.08(3)(e) 1865 Surveyor set a post, 1993 Surveyor set a 1 1/4" x 30" iron pipe as a temp. marker, 2004 Surveyors found the same. I found a 1.6" diameter iron pipe monument in 2026.

A-E 7.08(3)(f) I accept this monument in good faith as a FOUND PERPETUATED LOCATION of the corner.
A-E 7.08(3)(g)(h) This corner was not determined through lost-corner-proportionate methods.

A-E 7.08(3)(i) I, Jeffrey L. DeMuth, Professional Land Surveyor No. S-2656, hereby certify that the corner location on this record was determined by me or under my direction and control, and that this U.S. Public Land Survey Monument Record is correct and complete to the best of my knowledge, and belief.

WISCONSIN
Jeffrey DeMuth
S 2656
Arbor Vitae
WI
LAND SURVEYOR

SIGNATURE

October 27, 2026
DATE

43513180020

43513180020