
Electronically Filed on 11/11/2026
Forest County Land Information Office

U.S. PUBLIC LAND SURVEY MONUMENT RECORD

NOTE: This form is intended and designed to fufill all requirements of Wisconsin Administratvie Code, Chapter A-E 7.08 U.S. Public Land Survey Monument Record (3) (a-i)

A-E 7.08(3)(a) Identity of corner:
East 1/4 Corner Section 19,
Township 35 North, Range 13 East
of the Fourth Principal Meridian,
Town of Lincoln, Forest County, Wisconsin

WISCRS - FOREST COUNTY
N: 545,433.354 USft (XXX,XXX.XXX)
E: 836,010.573 USft (XXX,XXX.XXX)
Datum: NAD83 (2011)
GNSS Method RTN
GNSS Control WISCORS VRS

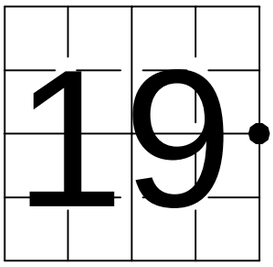

The coordinate value shown has been verified by the average of two or more GPS observations at a markedly different time. Coordinates shown in parenthesis are previously published values.

A-E 7.08(3)(b)


Original Surveyor: James L. Nowlin - September 11, 1865 to September 21, 1865
Tamarac 12 - S 80° W, 8 Links, Tamarac 10 - N 5° E, 15 Links

THENCE:


- February 18, 1993 - Surveyor 1394 - Norman A. Harrison - indicates this position as "existing Forest County aluminum monument" on county record Map #351319-19930218.
- February 10, 2004 - Surveyor 2197 - Michael A. Treml - indicates this position as "existing 2" Forest County aluminum monument" on county record Map #351320-20040210.

October 14, 2026 - While performing the 2026 - "PLSS Corner Remonumentation - Lincoln" project, I found a 2.4" diameter aluminum pipe with a 3.25" diameter aluminum cap stamped to identify the corner location. The monument is in a alder swamp, ±28' north and ±34' west of the northeast bank of Swamp Creek, and extends ±12" above grade. There are no available bearing trees and the ground is not suitable for iron witnesses. I established 0 new reference monuments as shown below.

A-E 7.08(3)(c)(d) Plan view of corner with references to at least 4 witness monuments.

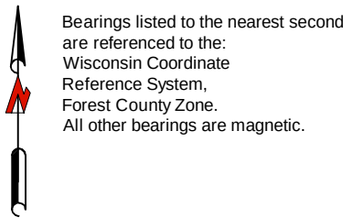

Bearings listed to the nearest second
are referenced to the:
Wisconsin Coordinate
Reference System,
Forest County Zone.
All other bearings are magnetic.

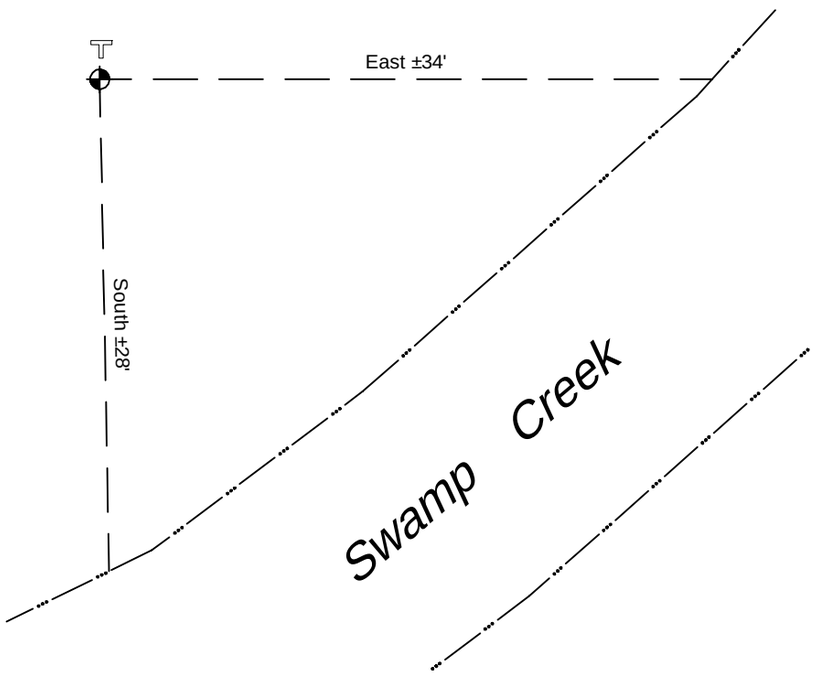

LEGEND

Monument sizes = outside diameter measurements.


This Corner
Vinyl T-post, set ±1.0 foot north of corner

0' 10' 20'

A-E 7.08(3)(e) 1865 Surveyor set a post, 1993 Surveyor & 2004 Surveyor both found a Forest County aluminum monument. I found a 2.4" diameter aluminum pipe with a 3.25" diameter aluminum cap in 2026.

A-E 7.08(3)(f) I accept this monument in good faith as a FOUND PERPETUATED LOCATION of the corner.
A-E 7.08(3)(g)(h) This corner was not determined through lost-corner-proportionate methods.

A-E 7.08(3)(i) I, Jeffrey L. DeMuth, Professional Land Surveyor No. S-2656, hereby certify that the corner location on this record was determined by me or under my direction and control, and that this U.S. Public Land Survey Monument Record is correct and complete to the best of my knowledge, and belief.

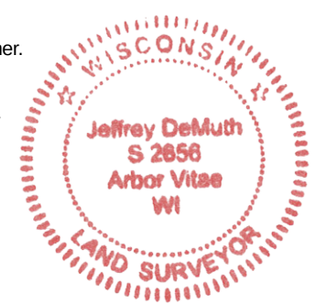

October 27, 2026
SIGNATURE DATE

43513192000

43513192000