
Electronically Filed on 11/12/2026
Forest County Land Information Office

U.S. PUBLIC LAND SURVEY MONUMENT RECORD

NOTE: This form is intended and designed to fufill all requirements of Wisconsin Administratvie Code, Chapter A-E 7.08 U.S. Public Land Survey Monument Record (3) (a-i)

A-E 7.08(3)(a) Identity of corner:
East 1/4 Corner Section 22,
Township 35 North, Range 13 East
of the Fourth Principal Meridian,
Town of Lincoln, Forest County, Wisconsin

WISCRS - FOREST COUNTY
N: 545,291.214 USft (XXX,XXX.XXX)
E: 851,892.897 USft (XXX,XXX.XXX)
Datum: NAD83 (2011)
GNSS Method RTN
GNSS Control WISCORS VRS

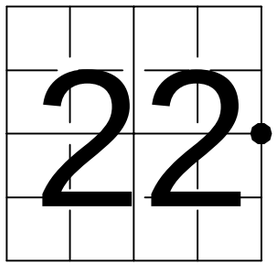

The coordinate value shown has been verified by the average of two or more GPS observations at a markedly different time. Coordinates shown in parenthesis are previously published values.

A-E 7.08(3)(b)

Original Surveyor: James L. Nowlin - September 11, 1865 to September 21, 1865
Sugar 8 - N 9° W, 20 Links, Birch 12 - S 18° E, 12 Links


See previous Restoration of Lost Original Government Survey Corner - P17 - January 12, 1965 - Surveyor 463 - Neal Sperhake - THENCE:

- August 15, 1977 - Surveyor 1125 - Paul N. Smith - indicates this position by symbol and notation "E 1/4" on county record Map #351322-19770815 (note: smith does not show a distance to the monument).
- June 1, 1987 - Surveyor 887 - Thomas R. Arnott - indicates this position as "iron pipe mon. found" on county record Map #351322-19870601.
- July 25, 1988 - Surveyor 1098 - William F. Kelly - indicates this position as "corner found in place" on Certified Survey Map, Volume 4 Page 43.
- July 1, 1993 - Surveyor 1107 - William B. Cochrane - indicates this position as "recovered Forest County record monument" on Certified Survey Map, Volume 4 Page 182.
- January 30, 1995 - Surveyor 1107 - William B. Cochrane - indicates this position as "recovered Forest County record monument" on Certified Survey Map, Volume 5 Page 18.
- October 12, 1998 - Surveyor 1795 - Devon Vanden Heuvel - indicates this position as "existing brass capped iron pipe" on county record Map #351322-19981012.
- September 22, 2000 - Surveyor 1616 - Steven J. Favorite - indicates this position as "3" dia. alum. capped monument found" on county record Map #351322-20000922.
- May 18, 2001 - Surveyor 1616 - Steven J. Favorite - indicates this position as "1" dia, alum. capped monument found (CPI)" on Certified Survey Map, Volume 6 Page 38 & county record Map #351323-20010518.
- September 4 & 11, 2007 - Surveyor 2656 - Jeffrey L. DeMuth - indicates this position as "Forest County monument found" on county record Map #351322-20070904, #351322-20070901 & #351322-20070911.
- March 9, 2018 - Surveyor 2671 - Timothy J. Rusch - indicates this position as "aluminum capped monument" on Certified Survey Map, Volume 9 Page 160.
- September 7, 2011 - Surveyor 2617 - Jeffrey M. Lieuwen - indicates this position as "found 2" al. pipe w/cap" on county record Map #351323-20110907 (note: Lieuwen does not show this monument as the 1/4 corner).
- May 18 & June 11, 2019 - Surveyor 1301 - Hugh W. Guy Jr. - indicates this position as "found Forest County monument" on county record Map #351322-20190518 & #351322-20190611.
- June 9, 2017 - Surveyor 2617 - Jeffrey M. Lieuwen - indicates this position as "found 2" al. pipe w/cap" on county record Map #351323-20170609 (note: Lieuwen does not identify this monument as the 1/4 corner).
- September 26, 2019 - Surveyor 2617 - Jeffrey M. Lieuwen - indicates this position as "found 2" al. pipe w/cap" on county record Map #351322-20190926 (note: Lieuwen does not identify this monument as the 1/4 corner).

October 20, 2026 - While performing the 2026 - "PLSS Corner Remonumentation - Lincoln" project, I found a 2.4" diameter aluminum pipe monument with a 3.25" diameter aluminum cap stamped to identify the corner location. The monument is on high ground and extends ±6" above grade. I did not find any of Sperhake's bearing trees. I established 4 new reference monuments as shown below.

Bearings listed to the nearest second are referenced to the: Wisconsin Coordinate Reference System, Forest County Zone. All other bearings are magnetic.

A-E 7.08(3)(c)(d) Plan view of corner with references to at least 4 witness monuments.

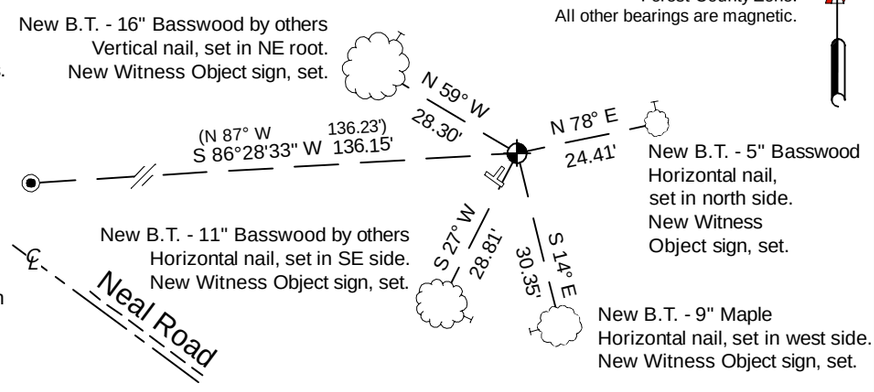

LEGEND

Monument sizes = outside diameter measurements.

- This Corner
- 2" diameter iron pipe, found
- Vinyl T-post, set ±1 foot SW of corner
- Galvanized nail, set or nail found as shown

0' 30' 60'

A-E 7.08(3)(e) 1865 Surveyor set a post, 1965 Surveyor found a 1" iron pipe, and replaced it with a galvanized iron pipe, 3 feet long, one inch in diameter with an aluminum cap stamped to identify the corner locatiion. Subsequent surveyors found similar.
I found a 2.4" diameter aluminum pipe monument with a 3.25" diameter aluminum cap in 2026.
A-E 7.08(3)(f) 1965 Surveyor states that this corner was restored through acceptance of a found perpetuated location.
A-E 7.08(3)(g)(h) This corner was not determined through lost-corner-proportionate methods.

A-E 7.08(3)(i) I, Jeffrey L. DeMuth, Professional Land Surveyor No. S-2656, hereby certify that the corner location on this record was determined by me or under my direction and control, and that this U.S. Public Land Survey Monument Record is correct and complete to the best of my knowledge, and belief.

WISCONSIN
Jeffrey DeMuth
S 2656
Arbor Vitae
WI
LAND SURVEYOR

SIGNATURE

October 27, 2026
DATE

43513222000

State of Wisconsin
County of FOREST } ss.

RESTORATION OF LOST ORIGINAL GOVERNMENT SURVEY CORNER.

I NEAL SPERHAKE, do hereby certify that on the SEVENTH day of OCTOBER, 19 64, I established the WEST QUARTER SECTION CORNER OF SECTION 23. TOWNSHIP 35 NORTH. RANGE 13 EAST, Fourth Principal Meridian, as described hereon.

History: This corner was established during the original survey of this township, as noted in the original field notes for the original survey of T35N-R13E, 4th. p.m.

Description of monument and accessories I established to perpetuate the location of this corner:


At the point determined for the location of the corner I emplaced a:

GALVANIZED IRON PIPE, THREE FEET LONG, ONE INCH IN DIAMETER, WITH ALUMINUM CAP DENOTED AS, "KIMBERLY CLARK CCRP. T35N ¼ BTWN. 22 & 23 R13E SPERHAKE RLS 463 10/7/64."

The pipe is witnessed by:

Poplar	7	S 68°E	32 links. (SCRIBED ¼ BT).
Basswood	5	S 27°W	44 links. (SCRIBED ¼ BT).

Description as to how corner was located: No evidence of the original corner is present. However, at a site that apparently has been accepted as the corner in question, was discovered a one inch iron pipe and two new bearing trees denoted as above. The trees are scribed BT instead of NBT, but since they've been scribed no longer than ten years ago, they can of course be only new bearing trees. I have been unable to discover who did the survey that established this point, or how it was done. I have been unable to locate anything north of this corner. At the start of the retracement survey the nearest known corner to the south was the town line corner of 34 and 35. The original distance between the town line corner of 34 and 35 and the quarter between 22 and 23 was 200 chains. The present distance from the corner of 34 and 35 and the iron pipe marking the quarter corner in question is 201.16 chains. This overage in 2½ miles is compatible with other work observed in this vicinity. A straight line was run between the town line corner of 34 and 35 and the iron pipe, and upon completion of the entire retracement survey performed in this area the corner of 26, 27, 34, 35 was found to be 15 links east of this line, and the corner of 22, 23, 26, 27, was found to be 60 links west of this line. This in itself proves nothing but it does point out that the iron pipe is on a meridian that is compatible with the east-west positions of the section corners to the south of it. Therefore, since both the north-south position of the pipe and its east-west position seem to be compatible with the general position of all the other corners located during the retracement survey of this entire area, I have accepted it as marking the site of the original quarter section corner between 22 and 23. I have used the existing new bearing trees as noted above as the witnessed to the pipe, emplaced another pipe and cap also as noted above, and recorded it.

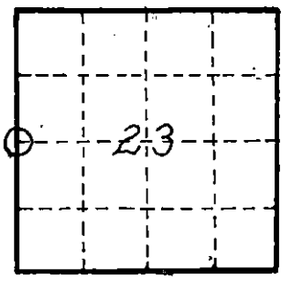

O = Corner monument restored

Resident witnesses

Dated at Crandon, Wisconsin, this 12th day of January, 19 65

Signature Neal Sperhake

Title Registered Land Surveyor Registration No. 463

Surveyor's Seal

Office of Forest County of Wisconsin,
I hereby certify that the within instrument was filed in this office for record on the 12th day of January 19 65, and was recorded in Book No. signed and Page No. sworn to of County Records. before me.

Signature Anna Peterson Title Notary Public

435132220 00

Index No. 017

JAN 12 19[illegible]
OFFICE
FOREST COUNTY, WIS.
89594
Register of Deeds