
Electronically Filed on 11/12/2026
Forest County Land Information Office

U.S. PUBLIC LAND SURVEY MONUMENT RECORD

NOTE: This form is intended and designed to fufill all requirements of Wisconsin Administratvie Code, Chapter A-E 7.08 U.S. Public Land Survey Monument Record (3) (a-i)

A-E 7.08(3)(a) Identity of corner:
East 1/4 Corner Section 22,
Township 35 North, Range 13 East
of the Fourth Principal Meridian,
Town of Lincoln, Forest County, Wisconsin

WISCRS - FOREST COUNTY
N: 545,282.845 USft (XXX,XXX.XXX)
E: 851,757.005 USft (XXX,XXX.XXX)
Datum: NAD83 (2011)
GNSS Method RTN
GNSS Control WISCORS VRS

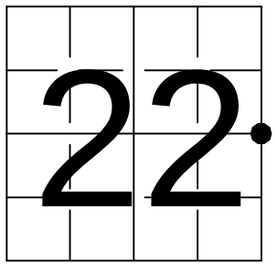

The coordinate value shown has been verified by the average of two or more GPS observations at a markedly different time. Coordinates shown in parenthesis are previously published values.

A-E 7.08(3)(b)


Original Surveyor: James L. Nowlin - September 11, 1865 to September 21, 1865
Sugar 8 - N 9° W, 20 Links, Birch 12 - S 18° E, 12 Links

See previous U.S. Public Land Survey Monument Record - P17A - December 13, 2011 - Surveyor 2617 - Jeffrey M. Lieuwen - THENCE:

- September 7, 2011 - Surveyor 2617 - Jeffrey M. Lieuwen - indicates this position as "set 1 1/4" x 18" iron pipe" on county record Map #351323-20110907.
- March 9, 2018 - Surveyor 2671 - Timothy J. Rusch - indicates this position as "Fd. iron pipe" on Certified Survey Map,
- Volume 9 Page 160.
- June 9, 2017 - Surveyor 2617 - Jeffrey M. Lieuwen - indicates this position as "found 1 1/4" pipe (set previous survey)" on county record Map #351323-20170609.
- September 26, 2019 - Surveyor 2617 - Jeffrey M. Lieuwen - indicates this position as "found 1 1/4" pipe (set previous survey)" on county record Map #351322-20190926.

October 20, 2026 - While performing the 2026 - "PLSS Corner Remonumentation - Lincoln" project, I found a 2" diameter iron pipe. The monument is on high ground in a windrow on the southwest woods line of Neal Road, and is flush with grade. I also found all of Lieuwen's bearing trees alive and in good condition. I established 0 new reference monuments as shown below.

A-E 7.08(3)(c)(d) Plan view of corner with references to at least 4 witness monuments.

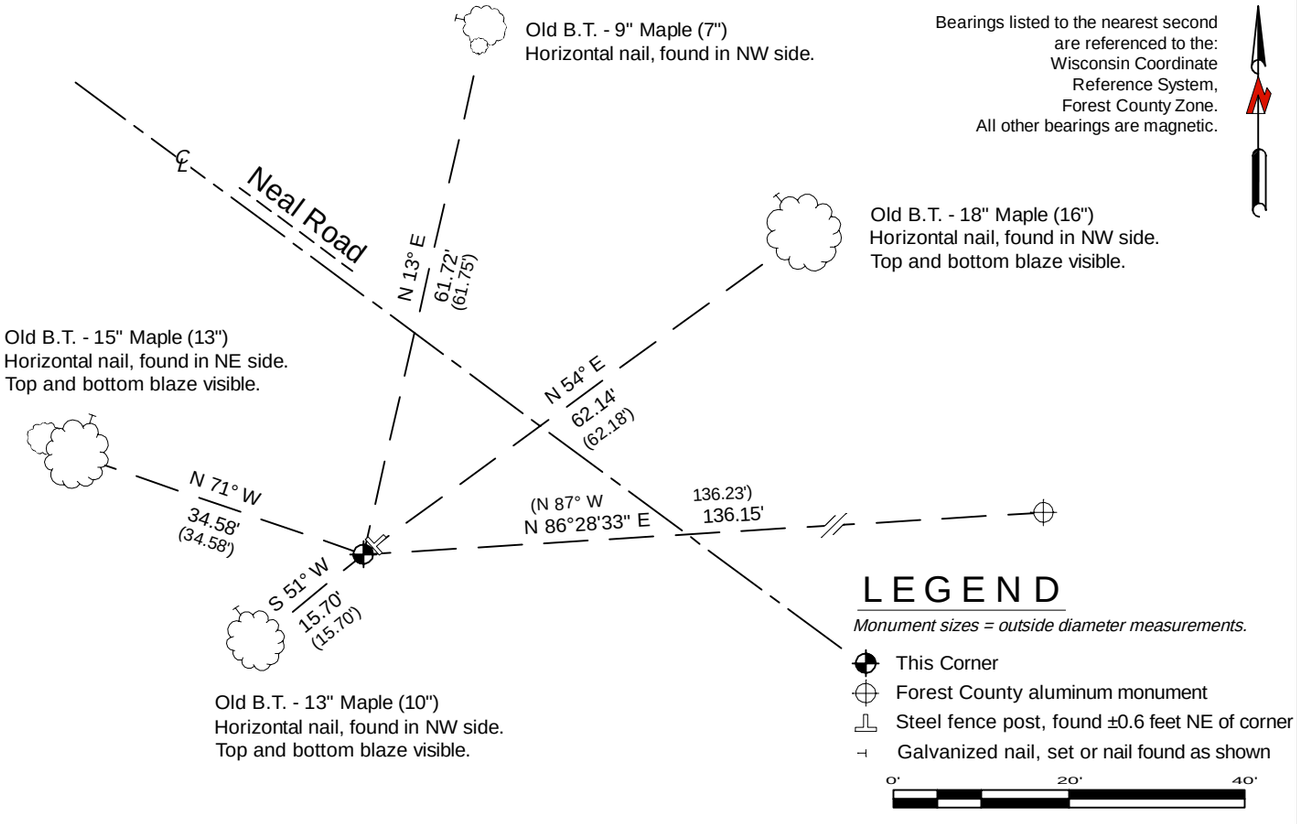

A-E 7.08(3)(e) 1865 Surveyor set a post, 2011 Surveyor found evidence of a rotted cedar and set a 1 1/4" iron pipe and fence post. I found a 2" diameter iron pipe in 2026.

A-E 7.08(3)(f) 2011 Surveyor states that this corner was restored through acceptance of a found perpetuated location.
A-E 7.08(3)(g)(h) This corner was not determined through lost-corner-proportionate methods.

A-E 7.08(3)(i) I, Jeffrey L. DeMuth, Professional Land Surveyor No. S-2656, hereby certify that the corner location on this record was determined by me or under my direction and control, and that this U.S. Public Land Survey Monument Record is correct and complete to the best of my knowledge, and belief.

WISCONSIN
Jeffrey DeMuth
S 2656
Arbor Vitae
WI
LAND SURVEYOR

SIGNATURE

October 27, 2026
DATE

43513222000

43513222000B

Document Number

207853

REGISTER'S OFFICE
Forest County, Wis.
Received for record this 16th day of DECEMBER A.D., 2011 at 9:00 o'clock A.M. and recorded in Vol. CORNER RESTORATION page P17A-P17C T35 R13
Courtney M Sutter Deputy
Register of Deeds

U.S. PUBLIC LAND SURVEY MONUMENT RECORD

(As Required By s. A-E 7.08, WI Adm. Code)

History of original corner establishment and subsequent restorations and description of any record, monument, occupational, testimonial or other evidence considered:

THIS CORNER WAS ESTABLISHED DURING THE ORIGINAL SURVEY OF THIS TOWNSHIP, AS NOTED IN THE ORIGINAL FIELD NOTES FOR THE ORIGINAL SURVEY OF T35N-R13E, 4th PRINCIPLE MERIDIAN

1965 NEAL SPERHAKE, S-463, SET KIMBERLY CLARK MONUMENT IN PLACE OF 1 INCH AND 2 "NEW" BEARING TREES


1993 GLEN BARKER, S-1682 REPLACED DAMAGED MONUMENT WITH NEW FOREST COUNTY MONUMENT

2011 SEE PAGE 2


Corner was: (Check All That Apply)

- ☐ Restored through acceptance of an obliterated evidence location
- ☒ Restored through acceptance of a found perpetuated location
- ☐ Considered a lost corner and reestablished through lost corner proportionate methods(include a plan view drawing showing distancees and directions to other Public Land Survey Corner used for proportioning and determining the corner location)
- ☒ Restored or reestablished in a location that differs from a previous restoration of reestablishedment(include a plan view drawing and indicate what was set and/or found)

Describe the monument and accessories used to perpetuate the location of this corner. (include a plan view drawing and indicate what was set and/or found

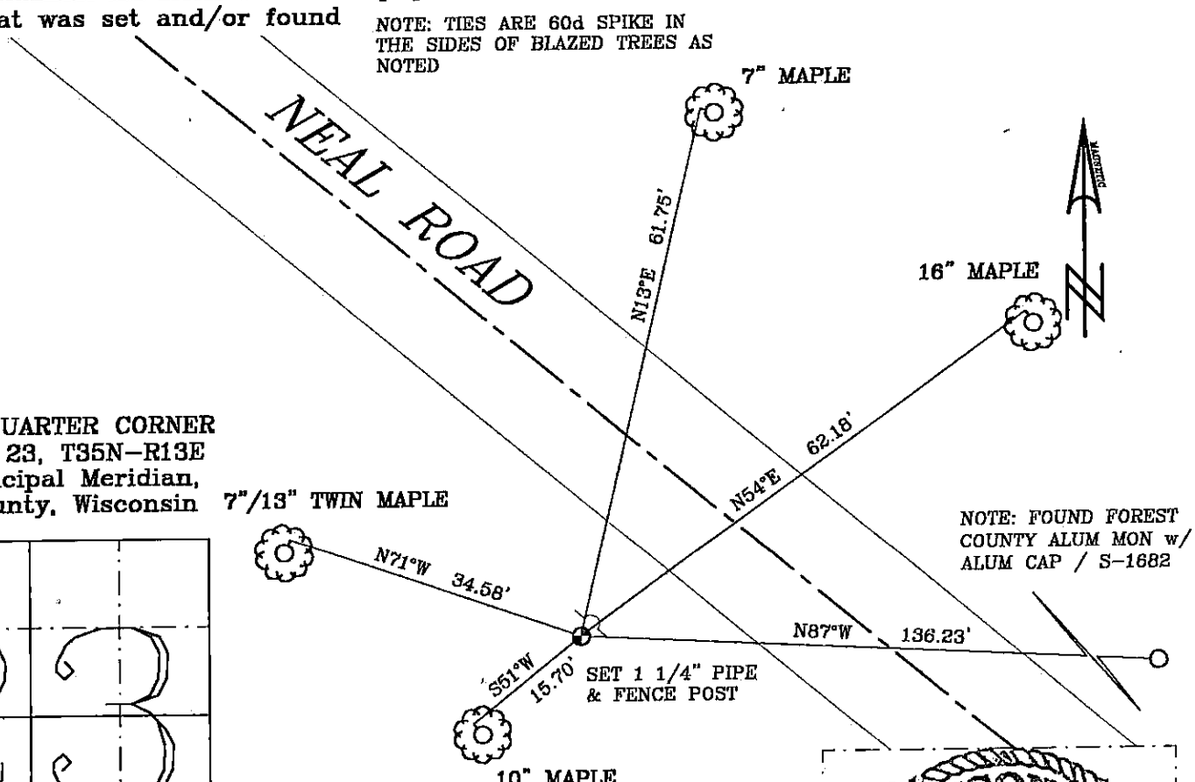

The WEST QUARTER CORNER of Section 23, T35N-R13E Forth Principal Meridian, Forest County, Wisconsin

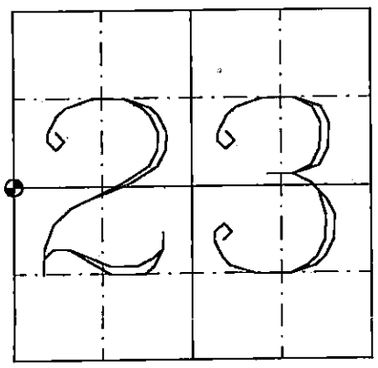

◔ = Location

Land Surveyor's Seal
WISCONSIN
JEFFREY M. LIEUWEN
S-2617
Crivitz
WI
LAND SURVEYOR

I, JEFFREY M. LIEUWEN RLS 2617
(type or print name) certify that the corner location shown on this record was determined by me or under my direction and control and that this U.S. Public Land Survey Monument Record is correct and complete to the best of my knowledge and belief.

Signature Dec 13, 2011 Date

Index No. P17A

43513222000


Quarter Corner, Sections 22 & 23, T35N-R13E

In May of 2008, we were hired by Cary Chmielewski to survey his parcel in Government Lot 1, Section 23, T35N-R13E, Town of Lincoln, Forest County, Wisconsin. Chmielewski's west line being the west line of Government Lot 1. In September 2007, Jeffrey L. DeMuth of MSA surveyed the Keberlein property located in Government Lot 1, Section 22, Keberlein's east line being Chmielewski's west line. The DeMuth survey places Keberlein's east line through Chmielewski's cabin.

As we started our research, Chmielewski provided us with a copy of a "Keith & Hiles Lumber Company" (K & H) map from 1908, at that time not on file with Forest County. With additional research to include surveys of record, monument records, deeds and a 1971 survey by Arvin M. Hess, establishing Chmielewski's south, east and north boundaries, this survey looked cut and dried, until we started comparing distances of record with the K & H map. This brought the validity of the Quarter Corner between Sections 22 & 23 into question.

In 1965, Neal Sperhake, surveyor for Kimberly Clark Corp found a 1-inch pipe with 2 B.T.'s, noting that B.T.'s are "no longer than 10 years old" (7" poplar & 5" basswood). Sperhake's position went unquestioned until now, except, possible by Sperhake himself. In reading Sperhake's history, I feel he is trying to talk himself into this position and with no better option (or mapping), he accepted the 1 inch pipe. Sperhake's Quarter Corner's is 136 feet east of a line from the Meander Corner to the Southwest Corner Section 23. The distance from the found 1 ¼ well point at the Center-of-Section 22, to Sperhake's Corner is 2862 feet compared to K & H' s distance of 2724.6 feet. As well as an angular difference (West Quarter Corner – Sperhake's Corner – Meander Corner) of 81°47'32" compared to K & H's angle of 86°46'. This caused more concern to Sperhake's Quarter Corner.

We looked at several options for resetting this corner and settled on setting it on a line from the Meander Corner to Southwest Corner of Section 23 at K & H's distance from said Meander Corner. This position puts the found 1 ¼ inch well point at the Center-of-Section 22, 0.51 feet south of the east – west quarter line and an angular comparison of 86°24'02" measured, 86°46' K & H record. We dug at this position and found evidence of a rotted cedar. Note area is upland, cut over hard woods, 5 to 10 feet south of roadway. Moving a Quarter Corner without strong original evidence is something not to be taken lightly. With that said, we feel we have no choice but to reset this corner based on the Keith & Hiles Lumber Company map.

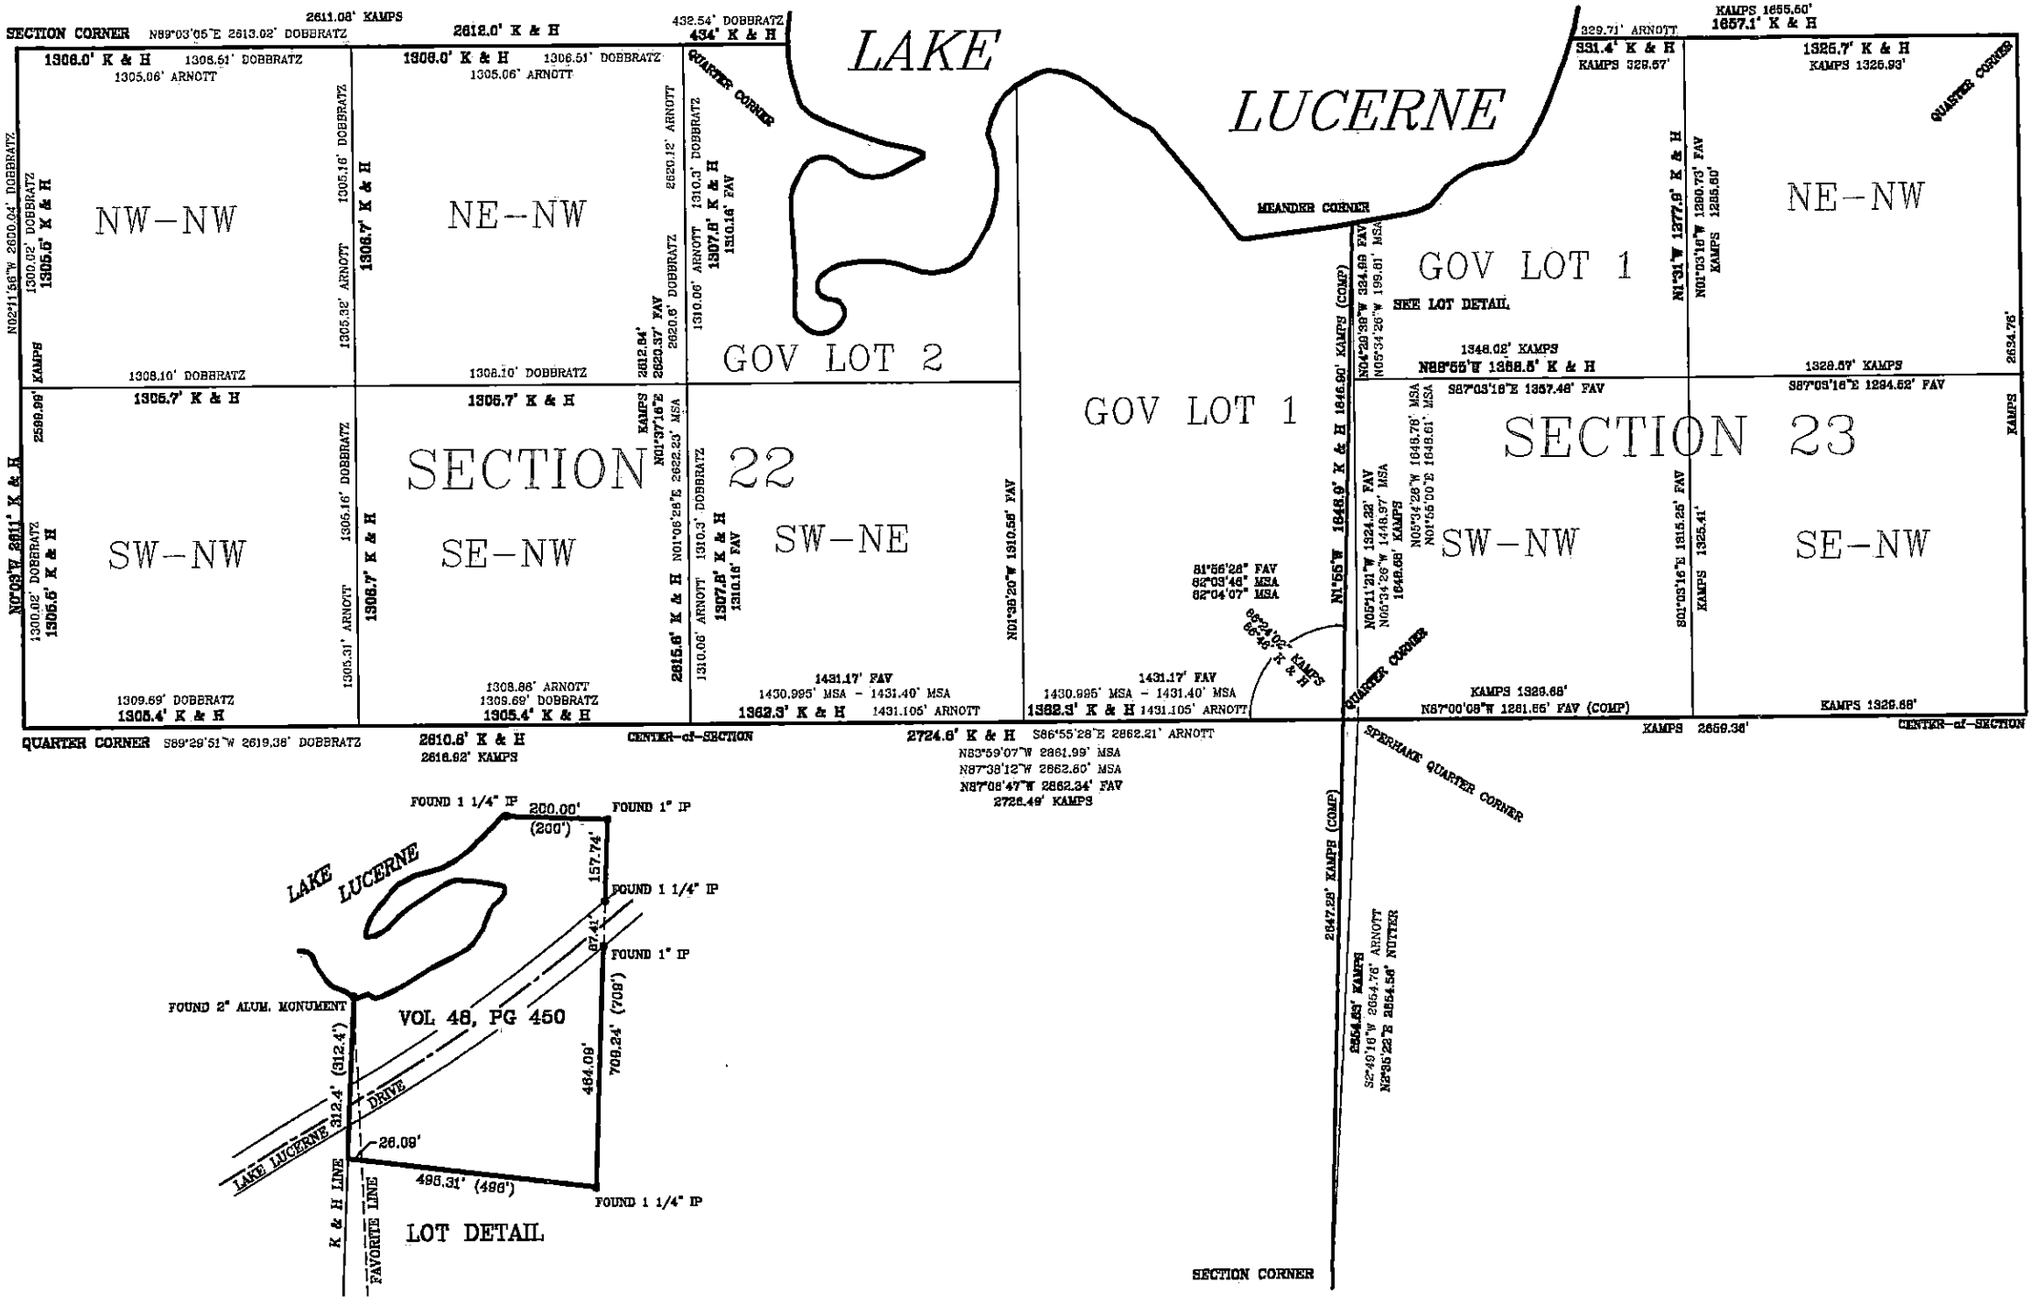
LAKE LUCERNE
GOV LOT 2
GOV LOT 1
GOV LOT 1
SECTION 22
SECTION 23
NW–NW
NE–NW
SW–NW
SE–NW
SW–NE
SW–NW
SE–NW
NE–NW
SEE LOT DETAIL.
SECTION CORNER
QUARTER CORNER
MEANDER CORNER
CENTER–of–SECTION
SPERHAKE QUARTER CORNER
FOUND 1 1/4" IP
FOUND 1" IP
FOUND 2" ALUM. MONUMENT
VOL 48, PG 450
DRIVE
LAKE LUCERNE
K & H LINE
FAVORITE LINE
LOT DETAIL

207853

P 12