Electronically Filed on 11/12/2026
Forest County Land Information Office

U. S. PUBLIC LAND SURVEY MONUMENT RECORD

NOTE: This form is intended and designed to fufill all requirements of Wisconsin Administratvie Code, Chapter A-E 7.08 U.S. Public Land Survey Monument Record (3) (a-i)

33

A-E 7.08(3)(a) Identity of corner:
Meander Corner - North shore of Lake
East line Section 33, Township 35 North,
Range 13 East, of the Fourth Principal
Meridian, Town of Lincoln, Forest County,
Wisconsin

WISCRS - FOREST COUNTY
N: 536,168.199 USft (XXX,XXX.XXX)
E: 846,613.949 USft (XXX,XXX.XXX)
Datum: NAD83 (2011)
GNSS Method RTN
GNSS Control WISCORS VRS

The coordinate value shown has been verified by the average of two or more GPS observations at a markedly different time. Coordinates shown in parenthesis are previously published values.

A-E 7.08(3)(b)


Original Surveyor: James L. Nowlin - September 11, 1865 to September 21, 1865
Aspen 6 - N 65° E, 4 Links, Birch 7 - N 45° W 40 Links

THENCE:

- November 14, 1961 - Surveyor 253 - Joseph C. Kirby - indicates this position as "iron pipe" on county record Map #351333-19611114.
- December 12, 1961 - Surveyor - F. R. Wincentsen - indicates this position by symbol and notation on county record Map #351333-19611221.
- May 1968 - Surveyor 309 - L. Ernest George - indicates this position as by symbol and notation on county record Map #351334-19680500.
- September 21, 1970 - Surveyor 887 - Thomas R. Arnott indicates this position as "iron pipe found" on county record Map 351334-19700921

May 6, 2026 - While performing the 2026 - "PLSS Corner Remonumentation - Lincoln" project, I found a 1.6" diameter iron pipe. The monument is on high ground ±2' from the shore of Ground Hemlock Lake, and extends ±5" above grade. I also found a 1.25" diameter iron pipe to the southeast of the meander corner. This pipe matches that a pipe noted on county record Map 351333-19700921.
I established 3 new reference monuments as shown below.

Bearings listed to the nearest second are referenced to the: Wisconsin Coordinate Reference System, Forest County Zone. All other bearings are magnetic.

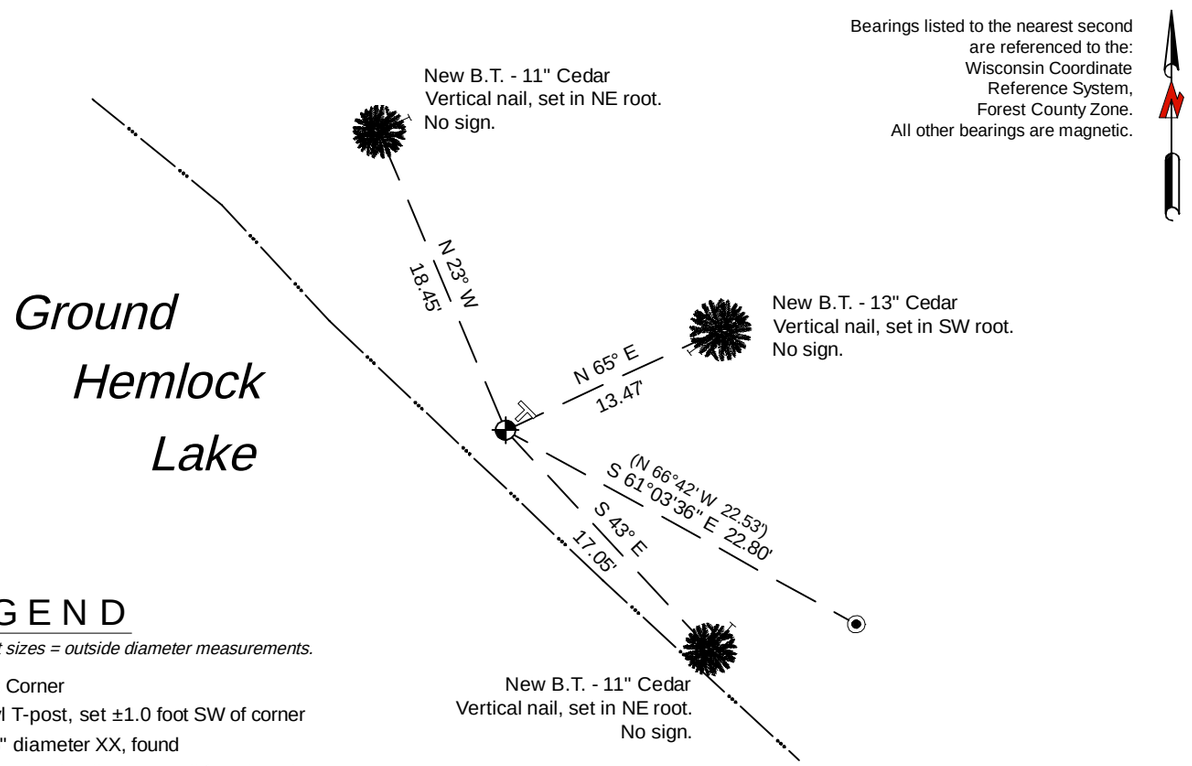

LEGEND

Monument sizes = outside diameter measurements.

- This Corner
- Vinyl T-post, set ±1.0 foot SW of corner
- 1.25" diameter XX, found
- Galvanized nail, set or nail found as shown

0' 10' 20'

A-E 7.08(3)(e) 1865 Surveyor set a post, subsequent Surveyors found an iron pipe. I found a 1.6" diameter iron pipe in 2026.

A-E 7.08(3)(f) I accept this monument in good faith as a FOUND PERPETUATED LOCATION of the corner.
A-E 7.08(3)(g)(h) This corner was not determined through lost-corner-proportionate methods.

A-E 7.08(3)(i) I, Jeffrey L. DeMuth, Professional Land Surveyor No. S-2656, hereby certify that the corner location on this record was determined by me or under my direction and control, and that this U.S. Public Land Survey Monument Record is correct and complete to the best of my knowledge, and belief.

WISCONSIN
Jeffrey DeMuth
S 2656
Arbor Vitae
WI
LAND SURVEYOR

Signature

May 22, 2026
Date

43513333000

43513330000