U.S. PUBLIC LAND SURVEY MONUMENT RECORD
FOREST COUNTY, WISCONSIN

TYPE OF MONUMENT: Found Aluminum Monument

SECTION 28 **TOWN** 36 **NORTH RANGE** 12 **EAST**


DOCUMENT NUMBER: 436122100020

CORNER INDEX NUMBER: R-11

CORNER LOCATION: North 1/4 Corner


Horizontal Datum:	NAD 83 (2011)
Vertical Datum:	NAVD 88 (Geoid 18)
Coordinate System:	WCCS, Forest County Zone
Units:	U.S. Survey Foot
Northing:	574509.086
Easting:	812862.477
Orthometric Height:	1756.74
Latitude:	N45°34'50.31617"
Longitude:	W88°59'35.30733"
Ellipsoid Height:	1647.88
Survey Date:	6/29/2026

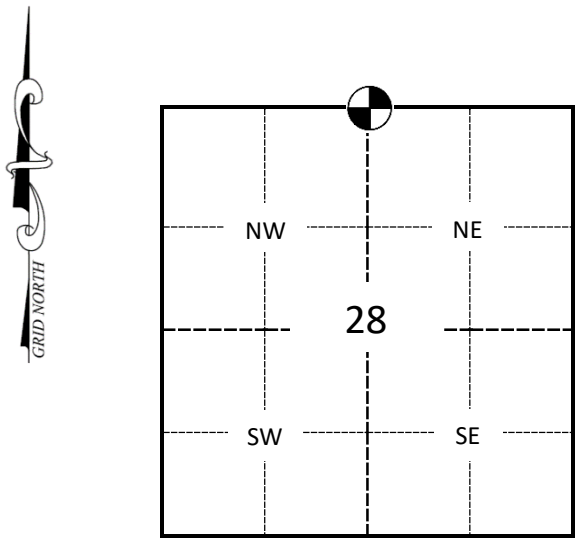

DESCRIPTION OF ORIGINAL MONUMENT AND ACCESSORIES AND SUBSEQUENT RESTORATIONS:

No corner tie sheet found on record

Undated Survey Map by Robert Kamps S-1754 filed as Forest County file No. 361221-20041026 shows the South Quarter Corner of Section 21 (North Quarter Corner of Section 28) with measurements to what the Legend depicts as a Found 2" Alum. Pipe w/3" Alum. Cap.

Survey Map Dated September 8th, 2006 by Kevin P. Bixby S-2343 filed as Forest County file No. 361228-20060908 shows the North Quarter Corner of Section 28 with measurements to what the Legend depicts as a Found Forest County Monument.

Plat of Survey Dated February 23rd, 2007 by Matthew E. Hoglund S-1910 filed as Forest County file No. 361228-20070223 shows the North Quarter Corner of Section 28 with measurement to what the Legend depicts as a Forest County Aluminum Monument Found.


EVIDENCE FOUND AND JUSTIFICATION FOR LOCATING CORNER AS SHOWN:

On June 29th, 2026, an Aluminum Monument was recovered as found by previous surveyors at the intersection of fence lines running East and South. No ties were found. Four 3/4" X 24" Iron Rods were set as new ties for the found monument.

LEGEND

- FOUND ALUMINUM MONUMENT
- SET 3/4" BY 24" IRON ROD
- FENCE LINE
- EDGE OF TRAIL

TIE SKETCH:
(not to scale)

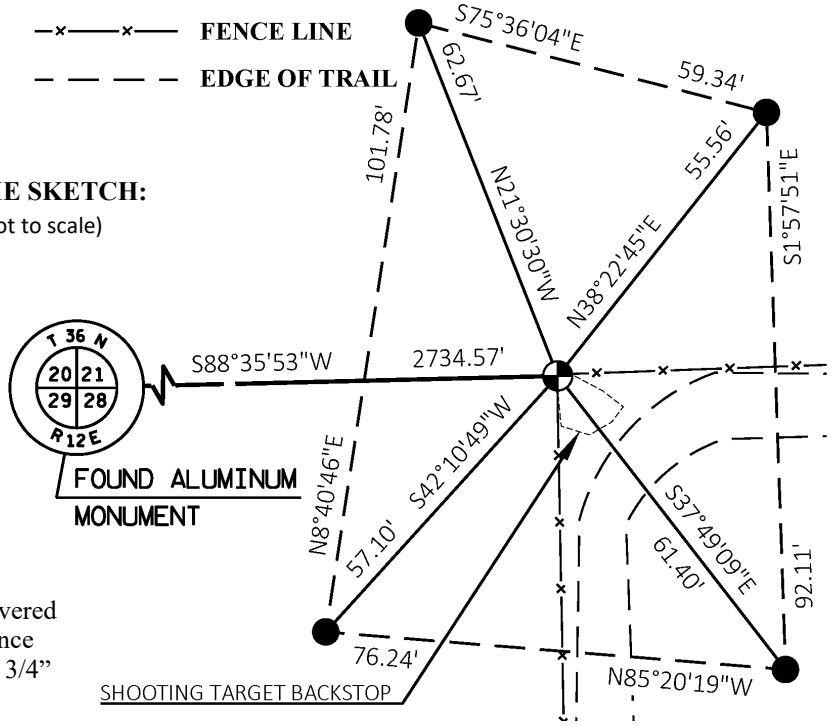

QUEST
Civil Engineers, LLC

320 West Grand Ave, Suite 302
Wisconsin Rapids, WI 54495

I certify that this record is correct and complete to the best of my knowledge and belief.

Kolby F. Schertz, PLS — 7/29/2026 Date
Wisconsin Registered Land Surveyor S-2862

WISCONSIN
KOLBY F. SCHERTZ
S-2862
SEYMOUR
WI
LAND SURVEYOR

Electronically Filed on 8/10/2026
Forest County Land Information Office

43612210020

Monument Pictures

Close up of Monument



Overview of monument



QUEST
Civil Engineers, LLC

320 West Grand Ave, Suite 302
Wisconsin Rapids, WI 54495

I certify that this record is correct and complete to the best of my knowledge and belief.

Kolby F. Schertz, PLS 7/29/2026
Kolby F. Schertz, PLS Date
Wisconsin Registered Land Surveyor S-2862

WISCONSIN
KOLBY F.
SCHERTZ
S-2862
SEYMOUR
WI
LAND SURVEYOR