Electronically Filed on 8/31/2026
Forest County Land Information Office

U. S. PUBLIC LAND SURVEY MONUMENT RECORD

NOTE: This form is intended and designed to fufill all requirements of Wisconsin Administratvie Code, Chapter A-E 7.08 U.S. Public Land Survey Monument Record (3) (a-i)

34.

A-E 7.08(3)(a) Identity of corner:
Meander Corner - East line Section 34,
Township 36 North, Range 14 East
of the Fourth Principal Meridian,
Town of Laona, Forest County, Wisconsin

WISCRS - FOREST COUNTY
N: 565,223.596 USft (XXX,XXX.XXX)
E: 883,784.661 USft (XXX,XXX.XXX)
Datum: NAD83 (2011)
GNSS Method RTN
GNSS Control WISCORS VRS

The coordinate value shown has been verified by the average of two or more GPS observations at a markedly different time. Coordinates shown in parenthesis are previously published values.

A-E 7.08(3)(b)

Original Surveyor: James McBride - July 25, 1859 to July 31, 1859
Birch 8 - N 9° W, 120 Links, Tamarac 6 - N 82° E, 22 Links


THENCE:

- September 18, 1940 - Surveyor - W. Stenerson - indicates this position as "2" x 30" iron pipe" and by notation "M.C." on the Sixth Addition to Silver Lake Park Plat.
- January 18, 1985 - Surveyor 1394 - Norman A. Harrison - indicates this position as "existing 1 1/4" iron pipe" and by notation "Meander Corner" on county record Map #361435-19850118.
- April 29, 2008 - Surveyor 2197 - Michael A. Treml - indicates this position as "existing 1 1/2" iron pipe" and by notation "M.C." on Certified Survey Map No. 198110.
- July 21, 2008 - Surveyor 2197 - Michael A. Treml - indicates this position as "existing 1 1/2" iron pipe" and by notation "M.C." on Certified Survey Map No. 198109.
- July 22, 2010 - Surveyor 2197 - Michael A. Treml - indicates this position as "existing 1 1/2" iron pipe" and by notation "M.C." on Certified Survey Map No. 203894.

May 26, 2026 - I found a 1.9" diameter iron pipe
±.5 feet south of a 4" x 4" cedar post point.
The monument is in a low wet area on the west
yard line of a home at 5020 W. Silver Lake Road, and
±2 feet north of the shore of Silver Lake.
The post point is rotted off at ground level,
and I believe it to be the original Meander Corner.

As the iron pipe fits well with the surveys mentioned above,
I accept it as the perpetuation of the original.
I established 3 new reference monuments as shown below.

A-E 7.08(3)(c)(d) Plan view of corner with references to at least 4 witness monuments.

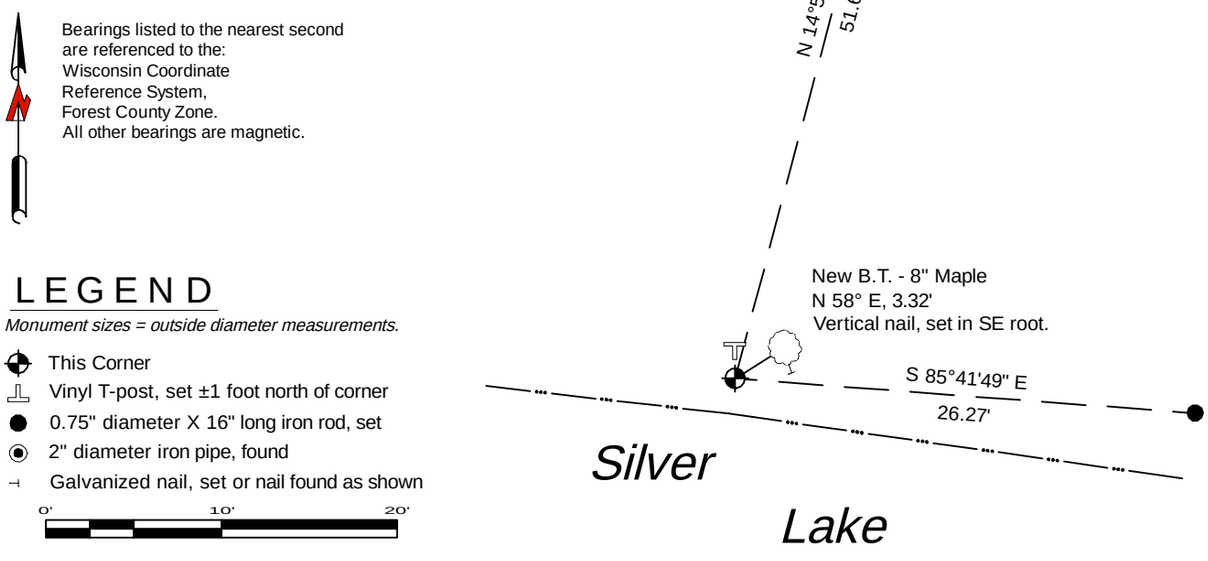

Bearings listed to the nearest second
are referenced to the:
Wisconsin Coordinate
Reference System,
Forest County Zone.
All other bearings are magnetic.

LEGEND

Monument sizes = outside diameter measurements.

- This Corner
- Vinyl T-post, set ±1 foot north of corner
- 0.75" diameter X 16" long iron rod, set
- 2" diameter iron pipe, found
- Galvanized nail, set or nail found as shown

0' 10' 20'

A-E 7.08(3)(e) 1859 Surveyor set a post, subsequent Surveyors found an iron pipe, I found a 1.9" diameter iron pipe, witnessed by a 4" x 4" cedar post point in 2026.

A-E 7.08(3)(f) I accept this monument in good faith as a FOUND PERPETUATED LOCATION of the corner.
A-E 7.08(3)(g)(h) This corner was not determined through lost-corner-proportionate methods.

A-E 7.08(3)(i) I, Jeffrey L. DeMuth, Professional Land Surveyor No. S-2656, hereby certify that the corner location on this record was determined by me or under my direction and control, and that this U.S. Public Land Survey Monument Record is correct and complete to the best of my knowledge, and belief.

WISCONSIN
Jeffrey DeMuth
S 2656
Arbor Vitae
WI
LAND SURVEYOR

June 4, 2026
Signature Date

43614341600

43614341600