Electronically Filed on 11/13/2026
Forest County Land Information Office


FOREST COUNTY

U. S. PUBLIC LAND SURVEY MONUMENT RECORD

NOTE: This form is intended and designed to fufill all requirements of Wisconsin Administratvie Code, Chapter A-E 7.08 U.S. Public Land Survey Monument Record (3) (a-i)

A-E 7.08(3)(a) Identity of corner:
Section Corner Common to Sections 25, 26, 35, & 36
Township 37 North, Range 13 East of the Fourth
Principal Meridian, Town of Argonne, Forest County, Wisconsin

WISCRS - FOREST COUNTY
N: 600,203.72 USft
E: 857,137.35 USft
Datum: NAD83 (2011)
GNSS Method RTK
GNSS Control WISCORS VRS

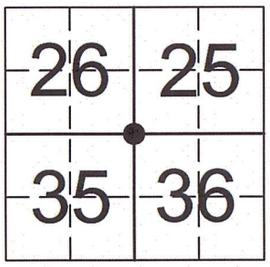

The coordinate value shown has been verified by the average of two or more GNSS observations.

A-E 7.08(3)(b)(e)
Original Surveyor: J.L. Nowlin – June 1865; Cedar 12", N35°W, 75 links; Sugar 15", S37°E, 60 lnks
No existing monument record on file.

2004- Michael Treml indicated he found an existing railroad spike in Forest County Survey file: 371336 - 20040629.

2005- Michael Treml indicated he found an existing railroad spike in Forest County Survey file: 371335 - 20050706

May 19th, 2026 - I located and accepted a railroad spike +/-5" below the surface of Wagoner Road. Established ties as indicated below.


A-E 7.08(3)(c)(d) Plan view of corner with references to at least 4 witness monuments.

LEGEND

Monument sizes = outside diameter measurements.

This Corner


0' 30' 60'

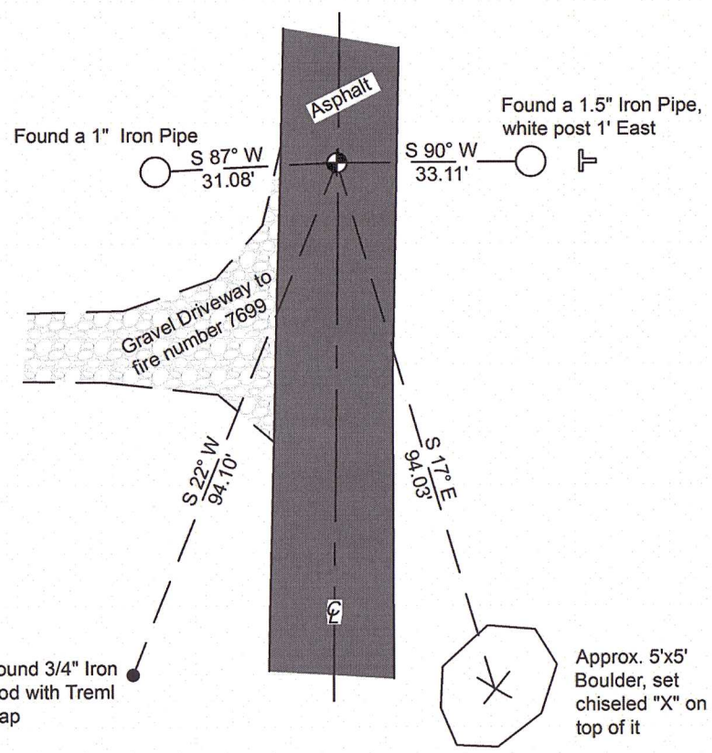



A-E 7.08(3)(f)(g)(h) I accept this monument in good faith as a FOUND PERPETUATED LOCATION of the corner and was not determined through lost-corner-proportionate methods.

A-E 7.08(3)(i) I, James E Anderson, Professional Land Surveyor No. S-3127, County Surveyor for Forest County, hereby certify that the corner location on this record was determined by me or under my direction and control, and that this U.S. Public Land Survey Monument Record is correct and complete to the best of my knowledge, and belief.

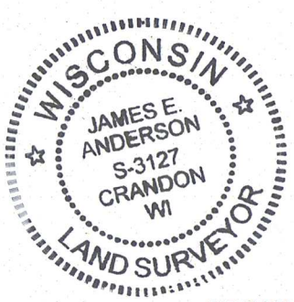

November 12th, 2026

SIGNATURE DATE

43713260000
SHEET 1 OF 1